


STATE OF KANSAS
STATE CORPORATION COMMISSION

WELL PLUGGING RECORD

Give All Information Completely
Make Required Affidavit
Mail or Deliver Report to:
Conservation Division
State Corporation Commission
211 No. Broadway
Wichita, Kansas

Pratt County, Sec. 5 Twp. 27S Rge. 12 (E) W (W)

NORTH

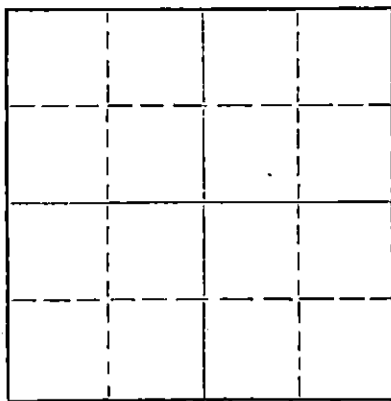

Locate well correctly on above
Section Plat

Location as "NE/CNW/SW" or footage from lines NW NW SE
Lease Owner W. J. Coppinger
Lease Name Dikeman Well No. 1
Office Address 507 Union National Bldg., Wichita, Kansas
Character of Well (completed as Oil, Gas or Dry Hole) Dry Hole
Date well completed Feb. 27, 1958
Application for plugging filed Feb. 27, 1958
Application for plugging approved Feb. 27, 1958
Plugging commenced Feb. 27, 1958
Plugging completed Feb. 27, 1958
Reason for abandonment of well or producing formation Dry Hole

If a producing well is abandoned, date of last production _____ 19____

Was permission obtained from the Conservation Division or its agents before plugging was commenced? Yes

Name of Conservation Agent who supervised plugging of this well Bill LeCamp, Stafford, Kansas

Producing formation _____ Depth to top _____ Bottom _____ Total Depth of Well 4262 Feet

Show depth and thickness of all water, oil and gas formations.

OIL, GAS OR WATER RECORDS

CASING RECORD

FORMATION	CONTENT	FROM	TO	SIZE	PUT IN	PULLED OUT
		0	341	8 5/8"	341	none

Describe in detail the manner in which the well was plugged, indicating where the mud fluid was placed and the method or methods used in introducing it into the hole. If cement or other plugs were used, state the character of same and depth placed, from _____ feet to _____ feet for each plug set.

From: 4262' to 330' - heavy rotary mud
330' to 267' - plug, 1/2 sack hulls and 20 sacks cem.
267' to 35' - heavy rotary mud
35' to 6' - plug, 1/2 sack hulls and 10 sacks cem.
6' to surface - cellar

RECEIVED
STATE CORPORATION COMMISSION
MAR 5 1958
CONSERVATION DIVISION
7545

(If additional description is necessary, use BACK of this sheet)

Name of Plugging Contractor Peel Brothers, Inc.
Address P.O. Box 88, Hoisington, Kansas

STATE OF KANSAS COUNTY OF BARTON, ss.
Peel Brothers, Inc. (employee of owner) or (owner) of the above-described

well, being first duly-sworn on oath, says: That I have knowledge of the facts, statements, and matters herein contained and the log of the above-described well as filed and that the same are true and correct. So help me God. PEEL BROTHERS, INC.

(Signature) BY [Signature]
P.O. Box 88, Hoisington, Kansas
(Address)

SUBSCRIBED AND SWORN TO before me this 3rd day of March 1958

My commission expires April 27, 1960

[Signature]
Notary Public.

PLUGGING
FILE SEC. 5 T. 27 R. 12
BOOK PAGE 87 LINE 1

DRILLERS' LOG

Well Owner: W. J. Coppinger
Farm Name: Dikeman #1
Commenced: 2/13/58
Completed: 2/27/58
Total Depth: 4262'
Casing: 8 5/8" @ 341' Cement
Contractor: Peel Brothers, Inc.

NW NW SE
Sec. 5-27S-12W
Pratt County, Kansas

Elevation:
Production: Dry

Figures below indicate bottoms of formations:

Sand and red bed	0 -	341
Red bed and shale		1115
Shale and shells		1570
Shale and lime		1850
Lime		2100
Shale and lime		3000
Shale, sand and lime		3110
Shale and lime		3150
Lime		3295
Lime and shale		3375
Lime		3450
Lime and shale		3811
Lime		4070
Lime and chert		4205
Lime, chert and sand		4227
Lime and sand		4231
Sand		4262
Total Depth		4262

This is to certify that the above information is to the best of our knowledge, true and correct.

PEEL BROTHERS, INC.

BY *[Signature]*

SUBSCRIBED AND SWORN to before me this 3rd day of March, 1958

My commission expires: April 27, 1960

[Signature]
Notary Public

RECEIVED
STATE CORPORATE COMMISSION

MAR 5 1958

CONSERVATION DIVISION
Wichita, Kansas

PLUGGING
FILE SEC. 5 T. 27 R. 12
BOOK PAGE 87 LINE 1