


STATE OF KANSAS
STATE CORPORATION COMMISSION

Give All Information Completely
Make Required Affidavit
Mail or Deliver Report to:
Conservation Division
State Corporation Commission
800 Bittling Building
Wichita, Kansas

WELL PLUGGING RECORD

NORTH

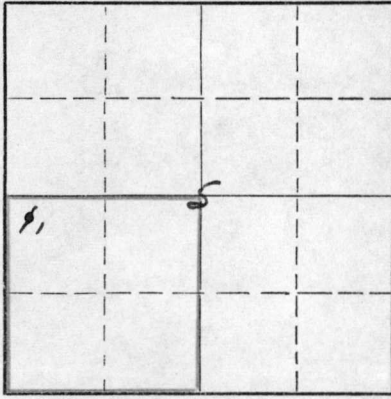

Locate well correctly on above
Section Plat

Pratt County. Sec. 5 Twp. 27S Rge. (E) 12 (W)
Location as "NE/CNW/SW" or footage from lines NW/4 NW/4 SW/4
Lease Owner Skelly Oil Company
Lease Name G. L. Hoener Well No. 1
Office Address Box 1650, Tulsa, Oklahoma
Character of Well (completed as Oil, Gas or Dry Hole) Dry Hole
Date well completed December 17, 1952
Application for plugging filed December 17, 1952
Application for plugging approved December 19, 1952
Plugging commenced January 21, 1953
Plugging completed February 3, 1953
Reason for abandonment of well or producing formation Dry Hole

If a producing well is abandoned, date of last production _____ 19____
Was permission obtained from the Conservation Division or its agents before plugging was commenced? Yes

Name of Conservation Agent who supervised plugging of this well Mr. M. A. Rives
Producing formation _____ Depth to top _____ Bottom _____ Total Depth of Well 4304 Feet
Show depth and thickness of all water, oil and gas formations.

OIL, GAS OR WATER RECORDS

CASING RECORD

FORMATION	CONTENT	FROM	TO	OD SIZE	PUT IN	PULLED OUT
<u>Simpson Sand</u>	<u>Dry</u>	<u>4224'</u>	<u>4290'</u>	<u>8-5/8"</u>	<u>447'0"</u>	<u>None</u>
<u>Arbuckle Lime</u>	<u>Dry</u>	<u>4290'</u>	<u>4304'</u>	<u>5-1/2"</u>	<u>4343'9"</u>	<u>2661'0"</u>

Describe in detail the manner in which the well was plugged, indicating where the mud fluid was placed and the method or methods used in introducing it into the hole. If cement or other plugs were used, state the character of same and depth placed, from _____ feet to _____ feet for each plug set.

Bridging plug 3790'
5 sacks of cement 3790' to 3770'
Mud laden fluid 3770' to 512'
100 sacks of cement 512' to 160'
Mud laden fluid 160' to 20'
5 sacks of cement 20' to 6'
Surface soil 6' to 0'

(If additional description is necessary, use BACK of this sheet)

Name of Plugging Contractor West Supply Company
Address Chase, Kansas

STATE OF Kansas, COUNTY OF Reno, ss.
H. E. Wamsley (employee of owner ~~owner~~ ~~operator~~) of the above-described well, being first duly sworn on oath, says: That I have knowledge of the facts, statements and matters herein contained and the log of the above-described well as filed and that the same are true and correct. So help me God.

(Signature) _____
Box 391, Hutchinson, Kansas
(Address)

SUBSCRIBED AND SWORN TO before me this 17th day of February, 1953

Notary Public.

My commission expires April 7, 1955

24-2675-S 2-52-20M

PLUGGING
FILE SEC 5 T 27 R 12W
BOOK PAGE 66 LINE 43


FEB 13 1953 2-13-53
CONSERVATION DIVISION
Wichita, Kansas

RECORD OF FORMATIONS

FORMATION	TOP	BOTTOM	REMARKS
Surface soil and sand	0	180	
Red bed and shale	180	452	Set and cemented 8-5/8" 282, 287, 291 thd., R-1, L.S. steel casing (A cond.) at 452' with 250 sacks of cement and 40 acugel. Cement did not circulate. Ran 50' of 3" pipe behind 8-5/8" casing and cemented around top of 8-5/8" casing with 100 sacks of cement.
Red bed	452	500	
Bed bed and shale	500	685	
Shale and shells	685	1260	
Salt and shale	1260	1700	
Lime	1700	2170	
Lime and shale	2170	2410	
Lime	2410	2530	
Shale and shells	2530	2595	
Lime and shale	2595	2925	
Lime	2925	3010	
Shale and lime	3010	3100	
Lime	3100	3250	
Lime and shale	3250	3340	
Lime	3340	3395	
Shale	3395	3440	
Lime	3440	3600	
Shale and lime	3600	3665	
Lime	3665	3782	TOP BRIDGE LIME 3665'
Fine crystalline lime	3782	3786	TOP LANTING LIME 3676'
Lime	3786	3844	Pinhole to oolitic porosity, spotty brown oil stain.
Oolitic lime	3844	3849	Spotty brown oil stain and dead oil
Lime	3849	3888	
Fine crystalline lime	3888	3896	Pin hole and oolitic porosity, spotty brown oil stain, probably dead oil.
Lime	3896	4110	
Lime and chert	4110	4162	TOP MISSISSIPPI LIME 4118'
Tripolitic chert	4162	4183	TOP VIOLA LIME 4142'
			Pin hole porosity and some vuggy porosity, good odor and free oil in wet sample.
			Run Halliburton drill stem test, packer set at 4146', used 37' of anchor, open 1 hour, gas to surface in 23 minutes, good blow for 1 hour. Recovered 65' of gas cut mud, BHP-1160.
Lime and chert	4183	4202	TOP SIMPSON SHALE 4196'
Shale	4202	4220	TOP SIMPSON DOLOMITE 4208'
Cored from 4220' to 4263' - Recovered 43'			
Top 4' - Shale			TOP SIMPSON SAND 4224'
Next 3'6" - Friable, oil saturated sand, good odor			
Next 6" - Sandy shale, very poor production of oil			
Next 16' - Streaks of oil saturated sand, 1" to 6" thick at irregular intervals in sandy shale, bleeding oil in spots, total of approximately 8' oil saturated sand in this interval.			
Next 4' - Sandy shale, bleeding oil in spots			
Next 4' - Shale with small streaks of patchy white sand, very poor oil show			
Next 8' - Shale with very thin streaks of sand, bleeding oil at scattered intervals of less than 1" thickness			
Last 3' - Green shale			
Cored from 4263' to 4270' - Recovered 7'			
All shale			
Drilled:			
Shale and lime	4270	4293	TOP RESOLLE LIME 4290'
Lime	4293	4295	
Tan, fine sucrosic to fine crystalline dolomite	4295	4300	No shows
			Set and cemented 5 1/2" 17 1/2, 8R thd., South Chester L.S. steel casing (A cond.) at 4297' with 200 sacks of Pozmix cement. Finished cementing at 5:00 a.m. 11/19/53.

SKELLY OIL COMPANY

1883' EB
1080' DF
1475' BH

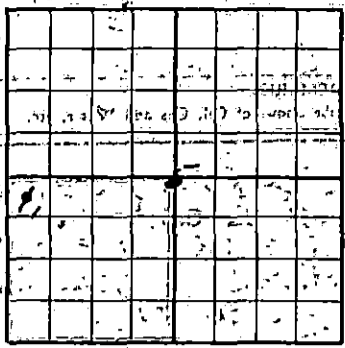

Well Record
 Lease Name and No. **O. L. Hoener** Well No. **1** Elev. **1475' BH**
 Lease Description **1/4 Section 5-27-12**
 Location made **October 31, 52** by **Pratt County Engineer**
330 feet from North line **330** feet from East line
11/1 19 **52** feet from South line **11/2** 19 **52** feet from West line of **Sec. 5**
 Work com'd **11/1** 19 **52** Rig com'd **11/2** 19 **52** Drlg. com'd **11/29** 19 **52**

Rig Contractor **Chas. Hulme Drilling Company**
 Drilling Contractor **Chas. Hulme Drilling Company, Great Bend, Kansas**
 Rotary Drilling from **0'** to **4298' BLM** Cable Tool-Drilling from **4298'** to **4304'**

Commenced Producing **DRY HOLE** 19 **52**
 Initial Prod. before shot or acid _____ Bbls.
 Initial Prod. after shot or acid _____ Bbls.

Dry Gas Well Press. _____ Volume _____ Cu. ft.
 Casing Head Gas Pressure _____ Volume _____ Cu. ft.
 Braden Head (_____ Size) Gas Pressure _____ Volume _____ Cu. ft.
 Braden Head (_____ Size) Gas Pressure _____ Volume _____ Cu. ft.

PRODUCING FORMATION **DRY HOLE** (Name) Top _____ Bottom _____ TOTAL DEPTH **4304'**

CASING RECORD

OD Size	Wt.	Thds.	Where Set	PULLED OUT			LEFT IN			KIND	Cond'n	CEMENTING	
				Jts.	Feet	In.	Jts.	Feet	In.			Sacks	Method Employed
8-5/8"	28.87	452'					21	447	0	R1 L	0	250	Halliburton
5-1/2"	17	8R 4297'		115	2661	0	72	1682	9	R1 L	2	200	Halliburton
(8-5/8" casing set 2' in collar)													

Liner Set at _____ Length _____ Perforated at _____
 Packer Set at _____ Size and Kind _____
 Packer Set at _____ Size and Kind _____

SHOT OR ACID TREATMENT RECORD

	FIRST	SECOND	THIRD	FOURTH
Date	11/30/52	12/4/52	12/9/52	
Acid Used, Size Shot			1500	
Shot Between	4252 Ft. and 4256 Ft.	4222 Ft. and 4238 Ft.	4143 Ft. and 4189 Ft.	
Size of Shell				For remaining treatments see remarks
Put in by (Co.)	Halliburton	Halliburton	Halliburton	
Length anchor				
Distance below Cas'g	(Hydrafrac)	(Hydrafrac)		
Damage to Casing or Casing Shoulder				

SIGNIFICANT GEOLOGICAL FORMATIONS

NAME	Top	Bottom	GAS		OIL		REMARKS
			From	To	From	To	
Brown Linc.	3664'						<div style="border: 2px solid black; padding: 5px; width: fit-content; margin: auto;"> <p style="margin: 0;">PLUGGING</p> <p style="margin: 0;">FILE SEC 5 T 27 R 122</p> <p style="margin: 0;">BOOK PAGE 66 LINE 43</p> </div>
Lancing Linc.	3678'						
Mississippi Linc.	4116'						
Viola Linc.	4142'						
Simpson Shale	4190'						
Simpson Sand	4224'						
Arbuckle Linc.	4290'						

CLEANING OUT RECORDS

	DATE COMMENCED	DATE COMPLETED	PROD. BEFORE	PROD. AFTER	REMARKS
1st					See Reverse for other details.
2nd					" " " " " "
3rd					" " " " " "
4th					" " " " " "

PLUGGING BACK AND DEEPENING RECORDS

	Date Commenced	Date Completed	No. Feet Plugged Back or Deepened	Prod. Before	Prgd. After	REMARKS
1st						See Reverse for other details.
2nd						" " " " " "
3rd						" " " " " "
4th						" " " " " "

Rigged up cable tools and bailed the hole dry on November 25, and shut down on account of snow storm. On November 26, drilled cement plug and cleaned out to bottom, and cement job and casing tested OK. Correction: 4300' SLM rotary table equals 4298' SLM derrick floor.

SLM 4300 4298

Ran Lane-Wells Gamma Ray Survey

Gray crystalline dolomite
Same

4298 4301
4301 4304

No shows
No shows

Bailed and tested 3 hours, 3 barrels of water with very slight accumulation of oil per hour.

Set Lane-Wells bridging plug at 4292' and plugged back with crushed rock and cement from 4292' to 4275'. On November 29, perforated 5 1/2" casing from 4252' to 4256' with 27 holes by Lane-Wells. Bailed and tested 8 hours, 1/2 gallon of oil and no water per hour. On November 30, ran 2" tubing and set Halliburton packer at 4195' and treated with Halliburton double Hydrafrac as follows:

HYDRAFRAC TREATMENT NO. 1 - Between 4252' and 4256'

Used 400y of Halliburton Gel
200 gallons of breaker agent
1500 gallons of kerosene
1200y of sand
Maximum TP-3800y, broke to 3200y
Time 14 minutes

Pulled tubing and packer and bailed and cleaned up hole. Swabbed through 5 1/2" casing 11 hours, 11 1/2 barrels of oil used to Hydrafrac. Bailed and tested 13 hours, 12 gallons of oil used to Hydrafrac and 12 gallons of formation water per hour.

On December 3, set Lane-Wells bridging plug at 4244' and plugged back with crushed rock to 4242'. Perforated 5 1/2" casing from 4222' to 4238' with 96 holes by Lane-Wells, no shows. On December 4, ran 2" tubing with Halliburton HM packer and set packer at 4150'. Treated with Halliburton double Hydrafrac from 4222' to 4238' as follows:

HYDRAFRAC TREATMENT NO. 2 - Between 4222' and 4238'

Used 500y of Gel
20 gallons of breaker agent
1400y of sand
1500 gallons of kerosene
Maximum TP-2700y, broke to 1600y
Time 23 minutes

Pulled tubing and packer and bailed the hole clean. Swabbed out oil, used to Hydrafrac, then bailed and tested 24 hours, 3 1/2 barrels of oil and 10-3/4 barrels of water. On December 7, swabbed through 5 1/2" casing 24 hours, 4-3/4 barrels of oil and 35 barrels of water.

On December 8, set Lane-Wells bridging plug at 4200' and plugged back from 4200' to 4190' with 3 gallons of crushed rock and 1 sack of cement. Perforated 5 1/2" casing from 4143' to 4183' with 120 holes by Lane-Wells. Bailed and tested 10 hours, 1 pint of oil and 3 gallons of water per hour. On December 9, treated through 5 1/2" casing with 1500 gallons of Halliburton 15% acid from 4143' to 4183' as follows:

ACID TREATMENT NO. 1 - Between 4143' and 4183'

Treatment put in 12/9/52 by Halliburton, using 1500 gallons of acid and 62 barrels of oil to fill and flush casing.

TIME	GP	TP	REMARKS
11:10 am			Start acid down casing
11:21 am			1500 gallons of acid in casing, start oil
11:35 am			1500 gallons of acid on bottom
11:37 am	500y		Hole loaded
12:30 pm	1000y		10 gallons of acid in formation
12:45 pm	1400y		15 gallons of acid in formation
12:50 pm	650y		500 gallons of acid in formation
12:54 pm	650y		1000 gallons of acid in formation
12:58 pm	700y		1500 gallons of acid in formation
1:00 pm	350y		Treatment completed

Swabbed through 5 1/2" casing 13 hours, 12 1/2 barrels of oil and acid water (used in treating); then tested 1 1/2 barrels of water with accumulation of oil per hour.

On December 10, set Lane-Wells bridging plug at 3930' and plugged back with crushed rock and cement to 3922'. Perforated 5 1/2" casing from 3886' to 3898' with 71 holes by Lane-Wells. Swabbed through 5 1/2" casing 12 hours, 6 barrels of oil and 67 barrels of water.

On December 11, set Lane-wells bridging plug at 3832' and perforated 5 1/2" casing from 3876' to 3881' with 35 holes by Lane-wells. Galled and tested 10 hours, no shows. On December 12, treated through 5 1/2" casing with 500 gallons of Halliburton 15% acid as follows:

ACID TREATMENT NO. 2 - Between 3876' and 3881'

Treatment put in 12/12/52 by Halliburton, using 500 gallons of acid and 109 barrels of oil to fill and flush.

TIME	CP	REMARKS
10:50 am		Started acid down casing
10:55 am		500 gallons of acid on bottom, started oil
11:30 am	500	Hole loaded
11:42 am	700	75 gallons of acid in formation
11:45 am	650	300 gallons of acid in formation
11:47 am	450	500 gallons of acid in formation

Swabbed out oil used in treating, then swabbed through 5 1/2" casing 9 hours, 2 barrels of oil and 23 barrels of water. On December 13, set Lane-wells bridging plug at 3865' and plugged back with crushed rock and cement to 3853'. Perforated 5 1/2" casing from 3844' to 3849' with 30 holes by Lane-wells. Galled and tested 14 hours, 4 gallons of water and no oil per hour. On December 14, treated through 5 1/2" casing with 500 gallons of Halliburton 15% acid as follows:

ACID TREATMENT NO. 3 - Between 3844' and 3849'

Treatment put in 12/14/52 by Halliburton, using 90 barrels of oil to fill and flush hole, and 500 gallons of acid.

TIME	CP	REMARKS
8:00 am		Started acid down casing
8:05 am		500 gallons of acid in casing, start oil
8:35 am	1000	Hole loaded
8:40 am	850	20 gallons of acid in formation
8:45 am	650	150 gallons of acid in formation
8:48 am	500	500 gallons of acid in formation and treatment completed

Swabbed out oil used in treating, then swabbed 15 hours, 2 barrels of oil and 40 barrels of water. Set Lane-wells bridging plug at 3828' and plugged back with crushed rock and cement from 3828' to 3820'. Perforated 5 1/2" casing from 3796' to 3808' with 48 holes by Lane-wells. Swabbed through 5 1/2" casing 11 hours, 17 barrels of salt water, no oil. Set Lane-wells bridging plug at 3790' and perforated 5 1/2" casing from 3782' to 3786' with 33 holes by Lane-wells, no shows. Treated through 5 1/2" casing with 500 gallons of Halliburton 15% acid as follows:

ACID TREATMENT NO. 4 - Between 3782' and 3786'

Treatment put in 12/16/52 by Halliburton, using 500 gallons of acid and 75 barrels of oil to fill and flush.

TIME	CP	REMARKS
3:40 pm		Start acid down casing
4:18 pm	500	Acid on bottom, start oil
4:22 pm	750	90 gallons of acid in formation
4:24 pm	500	250 gallons of acid in formation
4:26 pm	500	500 gallons of acid in formation

Swabbed out oil and acid water used in treating, then swabbed through 5 1/2" casing 5 hours, 23 1/2 barrels of salt water and no oil. While swabbing, hole filled 1940' with salt water. Galled 5 hours and could not lower fluid level. Hole filled 2300' with water. Since all probable pay zones in the well have been tested at this time, yielding no commercial amount of oil, regular authority was granted to plug and abandon the well.

On January 21, 1953, moved in tools of West Supply Company and plugged the well as follows:

5 sacks of cement 3790' to 3770'

Shot off 5 1/2" casing at 3200', 3100', and 3000'. Pulled on casing and coupling pulled off at 365'. Pulled 16 joints of 5 1/2" casing, 17 1/2, 2R thd., R-1, South Chester L.W. (B cond.). Ran 365' of 5 1/2" casing with overshot fishing tool, caught pipe and while pulling, lost hold on casing. Pulled 365' of 5 1/2" casing and fishing tool to check fishing tool. Repaired slips in tool. Ran 365' of 5 1/2" casing with Baasch-Boes fishing tool. Took hold of 5 1/2" casing and spotted 70 barrels of oil. Tried to pull casing and it would not move. Spotted 70 barrels of oil and tried to pull 5 1/2" casing, would not pull.

Ran one quart of nitroglycerin to 2900' and shot would not go off. Ran another quart of nitroglycerin, would not go below 2056'. Discharged both shots, but did not shoot off casing. Ran one quart of nitroglycerin to 2030' and shot discharged, shooting off casing at this point.

Pulled 115 joints (2661') of 5 1/2" OD, 17 1/2, 2R thd., R-1, South Chester, L.W. steel casing (B cond.). Finished plugging as follows:

Mud laden fluid 3770' to 512'
 100 sacks of cement 512' to 160'
 Mud laden fluid 160' to 20'
 5 sacks of cement 20' to 6'
 Surface soil 6' to 0'

Plugged and abandoned February 3, 1953.

WATER ANALYSIS

Pawhuska Research Laboratory

Sample Serial No.: 6462
 Sample taken from depth: 3796' to 3808'
 Date Secured: December 16, 1952
 Date Received: December 22, 1952
 Analysis Completed: December 24, 1952

PPM

Chlorides as Cl. 69,120
 Sulfates as SO₄ 2,420

Chlorides as NaCl. 114,090
 Sulfates as CaCO₃. 3,430

Sample Serial No.: 6463
 Sample taken from: 3844' to 3849'
 Date Secured: December 16, 1952
 Date Received: December 22, 1952
 Analysis Completed: December 24, 1952

PPM

Chlorides as Cl. 124,780
 Sulfates as SO₄ 224

Chlorides as NaCl. 205,690
 Sulfates as CaCO₃. 320

Sample Serial No: 6464
 Date Secured: December 16, 1952
 Date Received: December 22, 1952
 Analysis Completed: December 24, 1952

Depth Taken: 3876' to 3881'

PPM

Chlorides as Cl. 126,600
 Sulfates as SO₄ 154

Chlorides as NaCl. 208,670
 Sulfates as CaCO₃. 220

Sample Serial No: 6466
 Date Secured: December 17, 1952
 Date Received: December 22, 1952
 Analysis Completed: December 24, 1952

Depth Taken: 3782' to 3786'

Chlorides as Cl. 126,000
 Sulfates as SO₄ 340

Chlorides as NaCl. 207,680
 Sulfates as CaCO₃. 480

SLOPE TEST DATA

<u>DEPTH</u>	<u>ANGLE OF DEFLECTION</u>
500'	0 Degrees
750'	0 "
1000'	0 "
1250'	0 "
1500'	1/2 "
2000'	1/2 "
2250'	1/2 "
2500'	1/2 "
3070'	1/2 "
3640'	0 "