


STATE OF KANSAS
 STATE CORPORATION COMMISSION
 CONSERVATION DIVISION
 P. O. BOX 17027
 WICHITA, KANSAS 67217

FORM CP-4

WELL PLUGGING RECORD

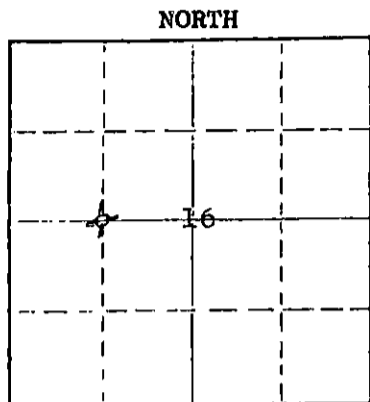

Locate well correctly on above Section Plat

Pratt County, Sec. 16 Twp. 27S Rge. 12W (E) (W)
 Location as "NE/CNW&SW" or footage from lines: C N/2 N/2 NW
 Lease Owner: Hummon Oil Company
 Lease Name: Josserand Well No. 1
 Office Address: 1725 Vickers-KSB&T Bldg., Wichita, Kansas
 Character of Well (completed as Oil, Gas or Dry Hole): Dry Hole
 Date well completed: November 19, 1977
 Application for plugging filed: November 19, 1977
 Application for plugging approved: November 19, 1977
 Plugging commenced: November 19, 1977
 Plugging completed: November 19, 1977
 Reason for abandonment of well or producing formation: Dry Hole

If a producing well is abandoned, date of last production: 19____
 Was permission obtained from the Conservation Division or its agents before plugging was commenced? Yes

Name of Conservation Agent who supervised plugging of this well: _____
 Producing formation: _____ Depth to top: _____ Bottom: _____ Total Depth of Well: 4185 Feet
 Show depth and thickness of all water, oil and gas formations.

OIL, GAS OR WATER RECORDS

CASING RECORD

FORMATION	CONTENT	FROM	TO	SIZE	PUT IN	PULLED OUT
		0'	373'	8-5/8"	366' 0"	None

RECEIVED
 STATE CORPORATION COMMISSION
 DEC 06 1977
 CONSERVATION DIVISION
 Wichita, Kansas

Describe in detail the manner in which the well was plugged, indicating where the mud fluid was placed and the method or methods used in introducing it into the hole. If cement or other plugs were used, state the character of same and depth placed, from _____ feet to _____ feet for each plug set.

Spotted with 40 sacks cement at 550',
 25 sacks cement at 360', 12 sacks cement
 with hulls and plug at 40', 3 sacks cement
 in rat hole.

(If additional description is necessary, use BACK of this sheet)

Name of Plugging Contractor: Allied Cementing Company
 Address: Box 31, Russell, Kansas 67665

STATE OF KANSAS COUNTY OF SEDGWICK ss.
 John D. Knightley, Agent, (employee of owner) or (owner or operator) of the above-described well, being first duly sworn on oath, says: That I have knowledge of the facts, statements, and matters herein contained and the log of the above-described well as filed and that the same are true and correct. So help me God.

(Signature) John D. Knightley
 301 S. Broadway, Wichita, Kansas
 (Address)

SUBSCRIBED AND SWORN TO before me this 30th day of November, 1977

My commission expires March 12, 1979 Notary Public: Stella J. Lips

Hummon Oil Company - Josserand #1
C N/2CN/2/NW Sec. 16-27S-12W
Pratt County, Kansas

Contractor: D. R. Lauck Oil Company, Inc.
301 S. Broadway
Wichita, Kansas 67202

Commenced: November 11, 1977
Completed: November 19, 1977

Drillers Log

Clay	35
Sand	140
Red Bed & Shale	376
Red Bed	975
Red Bed & Shale	1730
Shale & Shells	2410
Shale, Shells & Lime	2610
Shale & Shells	2775
Shale & Lime	3000
Shale & Shells	3245
Shale & Lime	3575
Shale & Shells	3740
Lime & Shale	3805
Lime	3940
Lime & Shale	4110
Lime & Chert	4185 RTD

RECEIVED
STATE CORPORATION COMMISSION

DEC 06 1977

CONSERVATION DIVISION
Wichita, Kansas