

STATE OF KANSAS
STATE CORPORATION COMMISSION

Form CP-4

Give All Information Completely
Make Required Affidavit
Mail or Deliver Report to:
Conservation Division
State Corporation Commission
211 No. Broadway
Wichita, Kansas

WELL PLUGGING RECORD

PRATT County, Sec. 15 Twp. 27S Rge. 12W (E) (W)
Location as "NE/CNW%SW%" or footage from lines C NE SE
Lease Owner MALLONEE-MAHONEY, INC.
Lease Name HARDESTY Well No. 1
Office Address BOX 1507, LIBERAL, KS. 67901
Character of Well (completed as Oil, Gas or Dry Hole) DRY HOLE
Date well completed 19____
Application for plugging filed 19____
Application for plugging approved 19____
Plugging commenced 5-22 19 76
Plugging completed 5-22 19 76
Reason for abandonment of well or producing formation _____

If a producing well is abandoned, date of last production 19____
Was permission obtained from the Conservation Division or its agents before plugging was commenced? _____

Name of Conservation Agent who supervised plugging of this well RUSSELL BEAVERSTIEN
Producing formation _____ Depth to top _____ Bottom _____ Total Depth of Well 4550' Feet
Show depth and thickness of all water, oil and gas formations.

OIL, GAS OR WATER RECORDS				CASING RECORD		
FORMATION	CONTENT	FROM	TO	SIZE	PUT IN	PULLED OUT

Describe in detail the manner in which the well was plugged, indicating where the mud fluid was placed and the method or methods used in introducing it into the hole. If cement or other plugs were used, state the character of same and depth placed, from _____ feet to _____ feet for each plug set.

200' - 50 SX COMMON
40' - 25 SX COMMON
RAT HOLE- 5 SX COMMON

RECEIVED
STATE CORPORATION COMMISSION
MAY 25 1976
CONSERVATION DIVISION
Wichita, Kansas

(If additional description is necessary, use BACK of this sheet)
Name of Plugging Contractor GABBERT-JONES INC.
Address WICHITA, KS.


STATE OF KANSAS, COUNTY OF SEWARD, ss.
B. A. CLIFFT (employee of owner) or (owner or operator) of the above-described

well, being first duly sworn on oath, says: That I have knowledge of the facts, statements, and matters herein contained and the log of the above-described well as filed and that the same are true and correct. So help me God.

(Signature) *B. A. Cliff*
Box 1507, LIBERAL, KS. 67901 (Address)

Subscribed and Sworn to before me this 24TH day of MAY, 19 76

Patricia A. Pennington
PATRICIA A. PENNINGTON Notary Public.

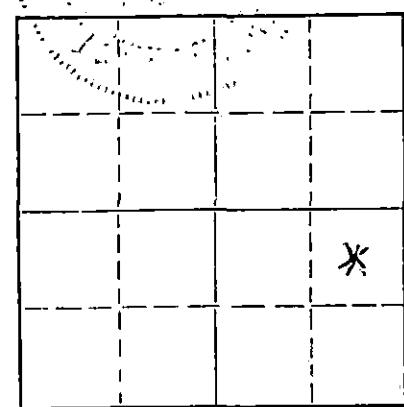

Locate well correctly on above Section Plot



GABBERT-JONES, INC.
 WICHITA, KANSAS
 DRILLERS' WELL LOG

HARDESTY #1
 C NE SE, Sec. 15-27S-12W
 PRATT COUNTY, KANSAS

COMMENCED: May 11, 1976
 COMPLETED: May 22, 1976

OPERATOR: MAHONEY DRILLING CO. & MALLONEE MAHONEY, INC.

Depth From	To	Formation	Remarks
0	150	Sand	Ran 7 jts of 54 1/2# 13 3/8"
150	1030	Redbed	csg. set @ 275' cemented w/
1030	1820	Shale-shells	300 sks common, 3% CC
1820	2145	Lime	P.D. 3:45 PM 5/11/76
2145	2285	Lime-shale	
2285	3505	Lime	
3505	3690	Shale-lime	
3690	4550	Lime	
4550		T.D.	

RECEIVED
 JUN 01 1976
 CONSERVATION DIVISION
 WICHITA, Kansas

DRY AND ABANDONED

I, James S. Sutton II, certify this is a correct copy of the Drillers' Log for the well drilled in the C NE SE, Section 15-27S-12W, Pratt County, Kansas to the best of my knowledge and belief.

James S. Sutton II
 James S. Sutton II

STATE OF KANSAS)
) SS
 COUNTY OF SEDGWICK)

Before me, the undersigned, a Notary Public within and for said County and State, on this 26th day of May, 1976, personally appeared James S. Sutton II to me personally acknowledged to me that he executed the same as his free and voluntary act and deed for the uses and purposes therein set forth.

IN WITNESS WHEREOF, I have hereunto set my hand and official seal the day and year last above written.

Marjorie Hall
 Marjorie Hall, Notary Public

My commission expires November 29, 1979

