


STATE OF KANSAS  
STATE CORPORATION COMMISSION

WELL PLUGGING RECORD

Give All Information Completely  
Make Required Affidavit  
Mail or Deliver Report to  
Conservation Division  
State Corporation Comm.  
245 North Water  
Wichita, KS 67202

Pratt County. Sec. 15 Twp. 27S Rge. 12W E/W  
Location as "NE/CNW $\frac{1}{2}$ SW $\frac{1}{2}$ " or footage from lines  
NW NE SW

Lease Owner Mallonee-Mahoney, Inc.  
Lease Name Roberts Well No. 1  
Office Address P.O. Box 1507, Liberal, Kan. 67901  
Character of Well (Completed as Oil, Gas or Dry Hole) Gas

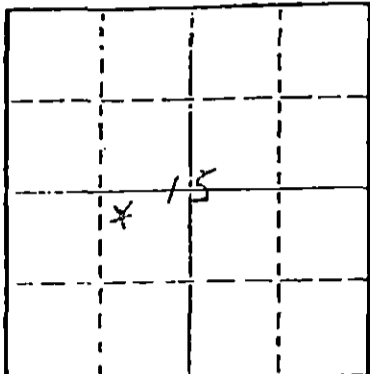

Locate well correctly on above  
Section Plot

Date Well completed 5-7- 1977  
Application for plugging filed 9-20- 1977  
Application for plugging approved 9-23- 1977  
Plugging commenced 10-17- 1977  
Plugging completed 10-19- 1977

Reason for abandonment of well or producing formation  
NON PRODUCING

If a producing well is abandoned, date of last production  
19

Was permission obtained from the Conservation Division or  
its agents before plugging was commenced? Yes

Name of Conservation Agent who supervised plugging of this well Bill Owens  
Producing formation \_\_\_\_\_ Depth to top 2480 Bottom 2483 Total Depth of Well 3803  
Show depth and thickness of all water, oil and gas formations.

OIL, GAS OR WATER RECORDS

CASING RECORD

FORMATION	CONTENT	FROM	TO	SIZE	PUT IN	PULLED OUT
				12 3/4	302	None
				4 1/2	2600	1700

Describe in detail the manner in which the well was plugged, indicating where the mud fluid was placed and the method or methods used in introducing it into the hold. If cement or other plugs were used, state the character of same and depth placed, from \_\_\_\_\_ feet to \_\_\_\_\_ feet for each plug set.

Bottom plugged off with 50 sacks cement pumped in.

3 sacks hulls and 20 sacks gel  
225 sacks 50-50 poz 2% gel to surface

RECEIVED  
STATE CORPORATION COMMISSION

OCT 28 1977

CONSERVATION DIVISION  
Wichita, Kansas

(If additional description is necessary, use BACK of this sheet)

Name of Plugging Contractor Clarke Corporation

STATE OF KANSAS COUNTY OF SEWARD, ss.  
RALPH HAMMOCK (employee of owner) or (owner or operator)  
of the above-described well, being first duly sworn on oath, says: That I have knowledge of the facts, statements, and matters herein contained and the log of the above-described well as filed and that the same are true and correct. So help me God.

(Signature) Ralph Hammock

Box 1507, LIBERAL, KS. 67901

(Address)

SUBSCRIBED AND SWORN TO before me this 27TH day of OCTOBER, 1977

Patricia A. Pennington

Notary Public.

PATRICIA A PENNINGTON

