


STATE OF KANSAS
STATE CORPORATION COMMISSION

WELL PLUGGING RECORD

Give All Information Completely
Make Required Affidavit
Mail or Deliver Report to
Conservation Division
State Corporation Comm.
245 North Water
Wichita, KS 67202

Pratt County. Sec. 15 Twp. 27S Rge. 12W E/W
Location as "NE/CNW $\frac{1}{2}$ SW $\frac{1}{2}$ " or footage from lines C SE NW

Lease Owner Hummon Corporation
Lease Name Englehardt Well No. 1
Office Address 400 One Main Place, Wichita, Kansas 67202
Character of Well (Completed as Oil, Gas or Dry Hole) Dry Hole

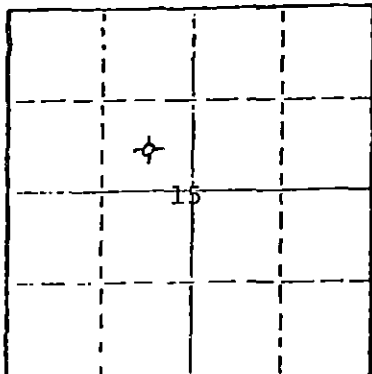

Locate well correctly on above
Section Plot

Date Well completed March 26, 1981
Application for plugging filed March 26, 1981
Application for plugging approved March 26, 1981
Plugging commenced March 26, 1981
Plugging completed March 26, 1981
Reason for abandonment of well or producing formation Dry Hole

If a producing well is abandoned, date of last production 19

Was permission obtained from the Conservation Division or its agents before plugging was commenced? Yes

Name of Conservation Agent who supervised plugging of this well Wm. T. Owen
Producing formation _____ Depth to top _____ Bottom _____ Total Depth of Well 2533'
Show depth and thickness of all water, oil and gas formations.

OIL, GAS OR WATER RECORDS

CASING RECORD

FORMATION	CONTENT	FROM	TO	SIZE	PUT IN	PULLED OUT
		0'	360'	10-3/4"	362.32'	None

Describe in detail the manner in which the well was plugged, indicating where the mud fluid was placed and the method or methods used in introducing it into the hold. If cement or other plugs were used, state the character of same and depth placed, from _____ feet to _____ feet for each plug set.


Plugged with 60 sacks cement at 650';
40 sacks cement at 350'; 20 sacks
cement and plug at 40'; and 15 sacks cement
in rat hole.

(If additional description is necessary, use BACK of this sheet)

Name of Plugging Contractor Allied Cementing Co.

STATE OF KANSAS COUNTY OF SEDGWICK, ss.
John H. Knightley Agent (employee of owner) or (owner or operator)
of the above-described well, being first duly sworn on oath, says: That I have knowledge of the facts, statements, and matters herein contained and the log of the above-described well as filed and that the same are true and correct. So help me God;

(Signature) John H. Knightley
221 S. Broadway, Suite 400, Wichita, KS 67202
(Address)

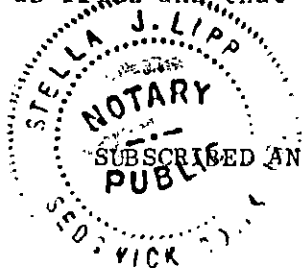

SUBSCRIBED AND SWORN TO before me this 6th day of April, 1981

Stella J. Lipp
Notary Public.

My commission expires March 12, 1983

Hummon Corporation
400 One Main Place
Wichita, Kansas 67202

-

Englehardt #1
C SE NW Sec. 15-27S-12W
Pratt County, Kansas

Contractor: D. R. Lauck Oil Company, Inc.
221 S. Broadway, Suite 400
Wichita, Kansas 67202

Commenced: March 23, 1981
Completed: March 26, 1981

Drillers Log

Sand & Red Bed	360
Red Bed	455
Shale & Shells	1920
Shale	2180
Shale & Lime	2345
Shale	2506
Shale & Lime	2533 RTD

RECEIVED
STATE CORPORATION COMMISSION
APR - 8 1981
CONSERVATION DIVISION
Wichita, Kansas