


STATE OF KANSAS  
STATE CORPORATION COMMISSION  
Give All Information Completely  
Make Required Affidavit  
Mail or Deliver Report to:  
Conservation Division  
State Corporation Commission  
800 Bittling Building  
Wichita, Kansas

WELL PLUGGING RECORD  
OR  
FORMATION PLUGGING RECORD

Strike out upper line  
when reporting plug-  
ging off formations.

NORTH

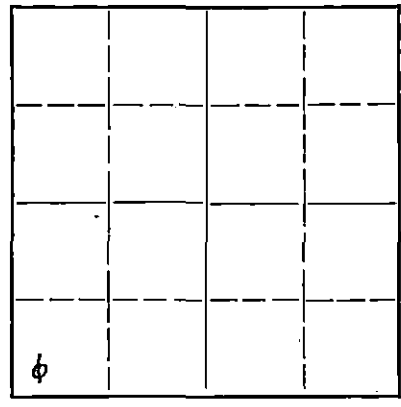

Locate well correctly on above  
Section Plat

Pratt County, Sec. 15 Twp. 27 Rge. 12 (W)  
Location as "NE1/4NW1/4SW1/4" or footage from lines 330' from South-330 from West  
Lease Owner Champlin Refining Company  
Lease Name Dora Allen Well No. 1  
Office Address Enid, Oklahoma  
Character of Well (completed as Oil, Gas or Dry Hole) Dry Hole  
Date well completed June 9, 1943 19  
Application for plugging filed June 9, 1943 19  
Application for plugging approved June 9, 1943 19  
Plugging commenced June 9, 1943 19  
Plugging completed June 9, 1943 19  
Reason for abandonment of well or producing formation Non-productive

If a producing well is abandoned, date of last production 19  
Was permission obtained from the Conservation Division or its agents before plugging was commenced? Yes

Name of Conservation Agent who supervised plugging of this well Mr. Burt Stafford  
Producing formation Depth to top Bottom Total Depth of Well 4533 Feet  
Show depth and thickness of all water, oil and gas formations.

OIL, GAS OR WATER RECORDS


CASING RECORD

Formation	Content	From	To	Size	Put In	Pulled Out
Arbuckle	Water	4472	4532	8-5/8"	901	None

Describe in detail the manner in which the well was plugged, indicating where the mud fluid was placed and the method or methods used in introducing it into the hold. If cement or other plugs were used, state the character of same and depth placed, from feet to feet for each plug set.

Total depth 4533' filled hole with heavy rotary mud - made bridge at 900' to 815' with 25 sacks of cement - filled with heavy rotary mud to 40' - filled with cement from 40' to 6' (bottom of cellar) used 15 sacks cement - left 901' of 8-5/8" O.D. surface casing in hole.

PLUGGING  
FILE SEC-15 T-27 R-12 W  
BOOK PAGE-78 LINE-14

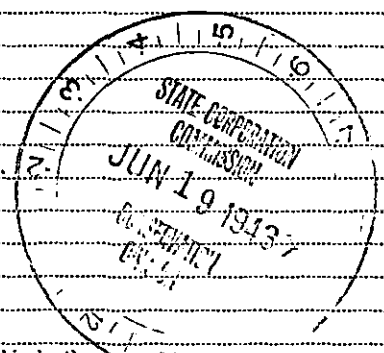

(If additional description is necessary, use BACK of this sheet)  
Correspondence regarding this well should be addressed to Champlin Refining Company  
Address Enid, Oklahoma

STATE OF Oklahoma COUNTY OF Garfield, ss.  
F. C. Wentworth (employee of owner) of the above-described well,  
being first duly sworn on oath, says: That I have knowledge of the facts, statements, and matters herein contained and the log of the above-described well as filed and that the same are true and correct. So help me God.

(Signature) F. C. Wentworth, Suph

Enid, Oklahoma (Address)  
SUBSCRIBED AND SWORN to before me this 18th day of June, 1943.  
Lore Bee Notary Public.  
My commission expires May 25, 1946.



### FORMATION RECORD

Give detailed description and thickness of all formations drilled through and contents of sand, whether dry, water, oil or gas.

Formation	Top.	Bottom	Formation	Top	Bottom
Sand	0	75			
Redbed& Sand	75	800			
Redbed & Shale	800	833			
Anhydrite	833	901			
Shale & Shells	901	1250			
Shale & Salt	1250	1575			
Salt & Shale	1575	1725			
Broken Lime	1725	1885			
Lime & Shale	1885	2205			
Shale & Lime	2205	2300			
Lime & Shale	2300	2420			
Shale & Lime	2420	3198			
Sand	3198	3226			
Lime	3226	3250			
S andy Lime & Shale	3250	3330			
Lime & Shale	3330	3415			
Shale & Lime	3415	3730			
Lime	3730	3965			
Lime & Shale	3965	3985			
Shale & Lime	3985	4015			
Lime & Shale	4015	4055			
Lime, chert & Shale	4055	4085			
Lime	4085	4104			
Lime & Shale, chert	4104	4155			
Shale, lime & chert	4155	4180			
Lime & Shale, strks, chert	4180	4225			
Lime & Shale	4225	4275			
Lime & Chert	4275	4355			
Lime & Sand	4385	4400			
Sand & Lime	4400	4415			
Sand & Shale	4415	4450			
Shale & Lime	4450	4485			
Lime	4485	4533			
T.D.	4533				

I, the undersigned, being first duly sworn upon oath, state that this well record is true, correct and complete according to the records of this office and to the best of my knowledge and belief.

(Signed) F. C. Wentworth  
Name and title of representative of company

Subscribed and sworn to before me this \_\_\_\_\_ day of \_\_\_\_\_, 194\_\_\_\_\_.

My Commission expires \_\_\_\_\_ Notary Public

COPY: Original filed in 1943.