

STATE OF KANSAS
STATE CORPORATION COMMISSION

Give All Information Completely
Make Required Affidavit
Mail or Deliver Report to:
Conservation Division
State Corporation Commission
800 Biting Building
Wichita, Kansas

WELL PLUGGING RECORD

PRATT

County. Sec. 12 Twp. 27S Rge. 12 (E) (W)

Location as "NE/CNW/SW" or footage from lines NW NW NW

Lease Owner FALCON SEABOARD DRILLING COMPANY

Lease Name ELWOOD Well No. 1

Office Address Stanolind Building, Tulsa, Oklahoma

Character of Well (completed as Oil, Gas or Dry Hole) Dry Hole

Date well completed Feb. 2, 19 57

Application for plugging filed Feb. 2 19 57

Application for plugging approved Feb. 4 19 57


Plugging commenced Feb. 2 19 57

Plugging completed Feb. 2 19 57

Reason for abandonment of well or producing formation

If a producing well is abandoned, date of last production 19

Was permission obtained from the Conservation Division or its agents before plugging was commenced? Yes

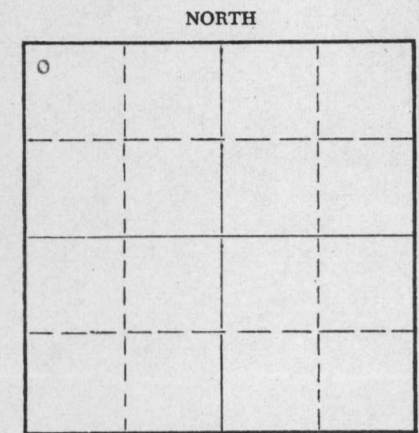

Locate well correctly on above Section Plat

Name of Conservation Agent who supervised plugging of this well M. A. Rives

Producing formation Depth to top Bottom Total Depth of Well 4609 Feet

Show depth and thickness of all water, oil and gas formations.

OIL, GAS OR WATER RECORDS

CASING RECORD

FORMATION	CONTENT	FROM	TO	SIZE	PUT IN	PULLED OUT
				10-3/4	771	None

Describe in detail the manner in which the well was plugged, indicating where the mud fluid was placed and the method or methods used in introducing it into the hole. If cement or other plugs were used, state the character of same and depth placed, from feet to feet for each plug set.

Hole was full of mud. Set HOWCO plug at 300' & cemented with 35 sacks.
Set HOWCO plug at 35' and cemented with 15 sacks to bottom of cellar.

(If additional description is necessary, use BACK of this sheet)

Name of Plugging Contractor FALCON SEABOARD DRILLING COMPANY
Address Stanolind Building, Tulsa, Oklahoma

STATE OF OKLAHOMA, COUNTY OF TULSA, ss. J. O. BROWN (employee of owner) or (owner or operator) of the above-described

well, being first duly sworn on oath, says: That I have knowledge of the facts, statements, and matters herein contained and the log of the above-described well as filed and that the same are true and correct. So help me God.

(Signature) J. O. Brown

SUBSCRIBED AND SWORN TO before me this 5th day of February, 19 57

February 8, 1958.

My commission expires

RECEIVED STATE CORPORATION COMMISSION

Notary Public.

PLUGGING FILE SEC 12 T 27 R 12W BOOK PAGE 138 LINE 33

FEB - 6 1957 CONSERVATION DIVISION Wichita, Kansas

WELL LOG

COMPANY: FALCON SEABOARD DRILLING COMPANY

Section 12-27S-12W

FARM: ELWOOD NO. 1

Location - NW NW NW

TOTAL DEPTH: 4609'

County - Pratt

COMM: 1-12-57. COMP: 2-2-57.

CASING

ELEVATION

10-3/4" - 771'

D.F. - 1863'

Gr. - 1854'

DRILLER'S LOG

Sand	0	175
Red Bed	175	444
Red Bed & Anhydrite	444	610
Red Bed, Anhydrite & Sand	610	703
Red Bed	703	868
Anhydrite, Red Bed & Shale	868	1241
Red Bed & Shale	1241	1495
Red Bed & Anhydrite	1495	1773
Shale & Shells	1773	1925
Shale & Lime	1925	2705
Shale & Sandy Lime	2705	2908
Lime & Shale	2908	3788
Lime	3788	4141
Lime & Chert	4141	4175
Chert	4175	4215
Lime & Chert	4215	4217
Lime & Shale	4217	4393
Shale & Cherty Lime	4393	4446
Sand & Lime	4446	4455
Sand & Cherty Lime	4455	4482
Lime & Shale	4482	4520
Cherty Lime & Shale	4520	4543
Shale & Sand	4543	4549
Cherty Lime	4549	4595
Sandy Lime & Chert	4595	4609
Total Depth	4609	

PLUGGING
 FILE SEC. 12 T. 87 R. 12W
 BOOK PAGE 138 LINE 33

RECEIVED
 STATE CORPORATION COMMISSION
 FEB - 6 1957
 CONSERVATION DIVISION
 Wichita, Kansas