


STATE OF KANSAS
STATE CORPORATION COMMISSION
CONSERVATION DIVISION
P. O. BOX 17027
WICHITA, KANSAS 67217

FORM CP-4

WELL PLUGGING RECORD

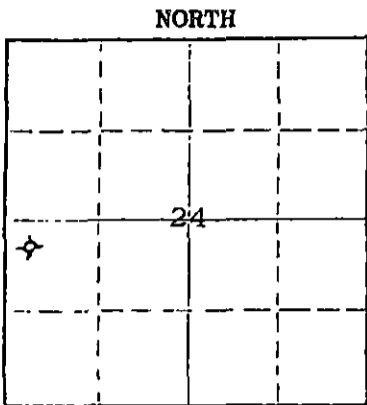

Locate well correctly on above Section Plat

Pratt County, Sec. 24 Twp. 27S Rge. 12W (NW) (W)
Location as "NE/CNW/SW" or footage from lines NW NW SW
Lease Owner Hummon Oil Company
Lease Name Carver Well No. 1
Office Address 1725 Vickers-KSB&T Bldg., Wichita, Kansas
Character of Well (completed as Oil, Gas or Dry Hole) Dry Hole
Date well completed September 16 1977
Application for plugging filed September 16 1977
Application for plugging approved September 16 1977
Plugging commenced September 16 1977
Plugging completed September 16 1977
Reason for abandonment of well or producing formation Dry Hole

If a producing well is abandoned, date of last production _____ 19____
Was permission obtained from the Conservation Division or its agents before plugging was commenced? Yes

Name of Conservation Agent who supervised plugging of this well _____
Producing formation _____ Depth to top _____ Bottom _____ Total Depth of Well 4400 Feet
Show depth and thickness of all water, oil and gas formations.

OIL, GAS OR WATER RECORDS

CASING RECORD

FORMATION	CONTENT	FROM	TO	SIZE	PUT IN	PULLED OUT
		0'	147'	12-1/2"	140.42'	None

Describe in detail the manner in which the well was plugged, indicating where the mud fluid was placed and the method or methods used in introducing it into the hole. If cement or other plugs were used, state the character of same and depth placed, from _____ feet to _____ feet for each plug set.

400' - 40 sacks cement,
120' - 35 sacks cement,
40' - 25 sacks cement,
1/2 sack hulls, and plug.

RECEIVED
CONSERVATION DIVISION
SEP 21 1977
WICHITA, KANSAS

(If additional description is necessary, use BACK of this sheet)
Name of Plugging Contractor Allied Cementing Company
Address Box 31, Russell, Kansas 67665

STATE OF KANSAS COUNTY OF SEDGWICK ss.
John D. Knightley (employee of owner) or (owner or operator) of the above-described

well, being first duly sworn on oath, says: That I have knowledge of the facts, statements, and matters herein contained and the log of the above-described well as filed and that the same are true and correct. So help me God.

(Signature) *John D. Knightley*
301 S. Broadway, Wichita, Kansas
(Address)

SUBSCRIBED AND SWORN TO before me this 26th day of September, 1977

My commission expires March 12, 1979
Stella J. Lips Notary Public.

Hummon Oil Company - Carver #1
NW NW SW Sec. 24-27S-12W
Pratt County, Kansas

Contractor: D. R. Lauck Oil Company, Inc.
301 S. Broadway
Wichita, Kansas 67202

Commenced: September 5, 1977
Completed: September 16, 1977

Drillers Log

Sand	138
Red Bed	450
Shale	1330
Shale & Lime	2160
Lime & Shale	2380
Shale & Lime	3585
Lime	4343
Cherty Lime	4390
Lime	4400 RTD

SEP 21 1977

SEP 21 1977

SEP 21 1977