


STATE OF KANSAS
STATE CORPORATION COMMISSION

WELL PLUGGING RECORD

Give All Information Completely
Make Required Affidavit
Mail or Deliver Report to:
Conservation Division
State Corporation Commission
211 No. Broadway
Wichita, Kansas

Pratt County, Sec. 23 Twp. 27 Rge. 12 (W)
Location as "NE/CNW/SW" or footage from lines C SW SW
Lease Owner D. R. Lauck Oil Company, Inc.
Lease Name Studer Well No. 1
Office Address 301 S. Broadway, Wichita, Kansas
Character of Well (completed as Oil, Gas or Dry Hole) Dry Hole
Date well completed July 16, 19 61
Application for plugging filed July 16, 19 61
Application for plugging approved July 16, 19 61
Plugging commenced July 16, 19 61
Plugging completed July 16, 19 61
Reason for abandonment of well or producing formation Dry Hole

NORTH

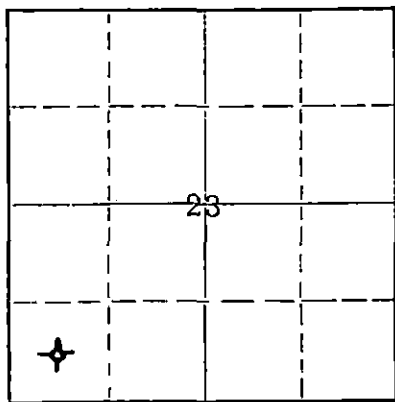

Locate well correctly on above
Section Plat

If a producing well is abandoned, date of last production -- 19 --
Was permission obtained from the Conservation Division or its agents before plugging was commenced? Yes

Name of Conservation Agent who supervised plugging of this well Frank Broadfort
Producing formation -- Depth to top -- Bottom -- Total Depth of Well 4550 Feet
Show depth and thickness of all water, oil and gas formations.

OIL, GAS OR WATER RECORDS

CASING RECORD

FORMATION	CONTENT	FROM	TO	SIZE	PUT IN	PULLED OUT
		0	282'	10-3/4"	282'	None

Describe in detail the manner in which the well was plugged, indicating where the mud fluid was placed and the method or methods used in introducing it into the hole. If cement or other plugs were used, state the character of same and depth placed, from _____ feet to _____ feet for each plug set.

4550' - 240' - Mud
240' - 236' - Plug
236' - 35' - Mud
35' - 31' - Plug
31' - 6' - Cement (Bottom of Cellar)

RECEIVED
STATE CORPORATION COMMISSION

JUL 26 1961

CONSERVATION DIVISION
Wichita, Kansas

(If additional description is necessary, use BACK of this sheet)

Name of Plugging Contractor Globe Cementing Company
Address Great Bend, Kansas

STATE OF KANSAS, COUNTY OF SEDGWICK, ss.
John H. Knightley (employee of owner) or (owner or operator) of the above-described well, being first duly sworn on oath, says: That I have knowledge of the facts, statements, and matters herein contained and the log of the above-described well as filed and that the same are true and correct. So help me God.

(Signature) John H. Knightley
John H. Knightley
301 S. Broadway, Wichita, Kansas
(Address)

SUBSCRIBED AND SWORN to before me this 24th day of July, 19 61.

My commission expires March 12, 1963

Stella J. Bodine
Stella J. Bodine Notary Public.

D. R. Lauck Oil Company, Inc.

Studer #1

C SW SW Sec. 23-27S-12W
Pratt County, Kansas

Commenced: July 3, 1961
Completed: July 16, 1961

Casing Record: 282' 10-3/4" Cemented with 240 sacks cement,
4 sacks Calcium Chloride.

Elevation: GL 1802; DF 1805; KB 1803.

Drillers Log

Tops

		Sample	Schlumberger
Sand	150	Heebner 3475-1668	3458-1651
Red Bed	600	Toronto 3490-1683	3472-1665
Lime	620	Douglas Shale 3514-1707	3496-1689
Shale & Shells	1650	Douglas Sand 3562-1755	3558-1751
Lime & Shale	2200	Brown Lime 3648-1841	3645-1838
Shale & Lime	2850	Lansing 3664-1857	3658-1851
Lime & Shale	2970	Kansas City 4020-2213	4017-2210
Chalky Lime & Shale	3170	Mississippian 4116-2309	4111-2304
Lime & Shale	3458	Kinderhook 4257-2450	4254-2447
Lime	4125	Viola 4305-2498	4304-2497
Chert	4140	Simpson Shale 4391-2584	4386-2579
Chert & Shale	4160	Simpson Sand 4397-2590	4393-2586
Lime & Shale	4178	Arbuckle 4499-2692	4496-2689
Lime, Shale, & Chert	4213	Total Depth 4550-2743	4546-2739
Shale, Chert & Lime	4249		
Shale, Sand & Lime	4280		
Lime & Shale	4307		
Chert & Shale	4345		
Lime, Shale & Chert	4388		
Shale & Sand	4445		
Shale	4476		
Shale, Lime & Sand	4500		
Lime	4550		

RTD

DST #1 (M) 4120-4140, open 1 hr.,
strong blow 1 hr. Gas to sfc.
too small to measure, 1 hr. 10
min. Recovered 100' mud.
ISIP 160# 20 min.
IFP 35#
FFP 48#
FSIP 110# 20 min.

DST #2 (M) 4140-4160, open 30 min.,
weak blow 5 min., flushed tool,
weak blow 2 min. Recovered 30'
mud.
ISIP 180# 20 min.
IFP 35#
FFP 48#
FSIP 110# 20 min.

RECEIVED
STATE CORPORATION COMMISSION
JUL 26 1961
CONSERVATION DIVISION
Wichita, Kansas

D&A