


Give All Information Completely
Make Required Affidavit
Mail or Deliver Report to:
Conservation Division
State Corporation Commission
211 No. Broadway
Wichita, Kansas

WELL PLUGGING RECORD

Pratt County, Sec 22 Twp. 27 Rge. 12 (E) (W)

Location as "NE/CNW/SW" or footage from lines C SW SW
Lease Owner Wayne Merchant
Lease Name Roberts Well No. 1
Office Address 227 Beacon Bldg., Wichita, Kansas
Character of Well (completed as Oil, Gas or Dry Hole) Dry Hole
Date well completed 6-17-65 19
Application for plugging filed 6-17-65 19
Application for plugging approved 6-17-65 19
Plugging commenced 6-17-65 19
Plugging completed 6-17-65 19
Reason for abandonment of well or producing formation Dry Hole

NORTH

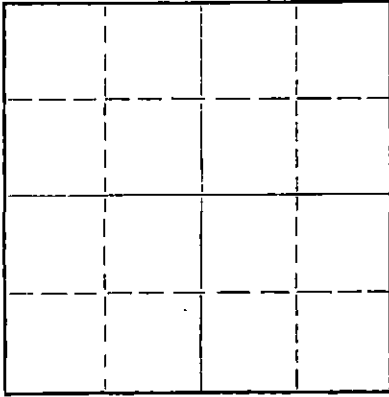

Locate well correctly on above
Section Flat

If a producing well is abandoned, date of last production 19
Was permission obtained from the Conservation Division or its agents before plugging was commenced? yes

Name of Conservation Agent who supervised plugging of this well Archie Elving, Pratt, Kansas
Producing formation Depth to top Bottom Total Depth of Well 4500 Feet
Show depth and thickness of all water, oil and gas formations.

OIL, GAS OR WATER RECORDS

CASING RECORD

FORMATION	CONTENT	FROM	TO	SIZE	PUT IN	PULLED OUT
				8 5/8"	301'	none

Describe in detail the manner in which the well was plugged, indicating where the mud fluid was placed and the method or methods used in introducing it into the hole. If cement or other plugs were used, state the character of same and depth placed, from feet to feet for each plug set.

Mud to 260' Plug 1/2 sk. hulls 25 sks. cement
Mud to 40' Plug 1/2 sk. hulls 10 sks. cement
2 sks. in rathole

RECEIVED
STATE CORPORATION COMMISSION

JUN 29 1965

CONSERVATION DIVISION
Wichita, Kansas

(If additional description is necessary, use BACK of this sheet)

Name of Plugging Contractor Leben Drilling, Inc.
Address Box 486, Great Bend, Kansas 67530

STATE OF KANSAS, COUNTY OF BARTON, ss.
James M. Battin (employee of owner) or (owner or operator) of the above-described

well, being first duly sworn on oath, says: That I have knowledge of the facts, statements, and matters herein contained and the log of the above-described well as filed and that the same are true and correct. So help me God.

(Signature) James M. Battin
P. O. Box 486, Great Bend, Kansas
(Address)

SUBSCRIBED AND SWORN TO before me this 23rd day of June, 1965

Wanda D. Nichols
Notary Public.

My commission expires April 1, 1967

DRILLER'S LOG

COMPANY: Wayne Merchant
 CONTRACTOR: LEBEN DRILLING, INC.
 FARM: ROBERTS #1
 LOCATION: C SW SW Sec. 22-27-12
 PRATT COUNTY, KANSAS
 COMMENCED: 6-7-65
 COMPLETED: 6-17-65

0	200	Sand
200	240	Clay & Gravel
240	302	Redbed
302	670	Redbed & Shale
670	1635	Shale & Shells
1635	1880	Shale
1880	2300	Lime & Shale
2300	2590	Shale & Sand
2590	2875	Shale & Lime
2875	3285	Shale
3285	3585	Lime & Shale
3585	4117	Lime
4117	4200	Lime & Chert
4200	4224	Lime
4224	4257	Chert
4257	4271	Lime & Shale
4271	4364	Lime
4364	4400	Lime & Chert
4400	4418	Simpson Sand
4418	4425	Lime & Shale
4425	4500	Lime
	<u>4500</u>	<u>RTD - D. & A.</u>

Set 8 5/8" used surface casing @ 301' with 250 sacks 60-40 Posmix with 2% Gel

I, James M. Battin, do hereby certify that the above and foregoing is a true and correct copy of the log of the Roberts #1 well, located C SW SW of Section 22, Township 27, Range 12, Pratt County, Kansas, as reflected by records of Leben Drilling, Inc.

James M. Battin
 James M. Battin

STATE OF KANSAS)
) SS
 COUNTY OF BARTON)

Subscribed and sworn to before me, a Notary Public, in and for Barton County, Kansas, this 23rd day of June, 1965.

Ulanda Nichols
RECEIVED
 STATE CORPORATION COMMISSION Ulanda Nichols

My Commission Expires:
 April 1, 1967

JUN 29 1965

CONSERVATION DIVISION
 Wichita, Kansas