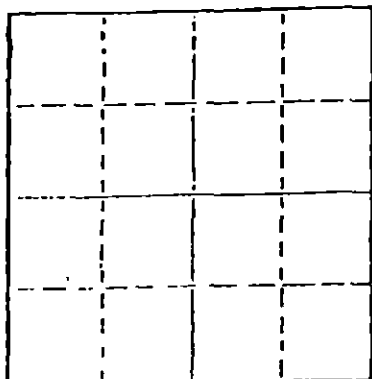


STATE OF KANSAS
STATE CORPORATION COMMISSION

WELL PLUGGING RECORD

Give All Information Completely
Make Required Affidavit
Mail or Deliver Report to
Conservation Division
State Corporation Comm.
245 North Water
Wichita, KS 67202

Locate well correctly on above
Section Plat

Pratt County. Sec. 32 Twp. 27 Rge. 12 E/W
Location as "NE/CNW $\frac{1}{4}$ SW $\frac{1}{4}$ " or footage from lines
SE NE NE
Lease Owner Zorger Oil Co.
Lease Name Lunt #1 Well No.
Office Address Wichita, Kansas 67202
Character of Well (Completed as Oil, Gas or Dry Hole)

Date Well completed 19
Application for plugging filed 19
Application for plugging approved 19
Plugging commenced 5/25/78 19
Plugging completed 5/30/78 19
Reason for abandonment of well or producing formation
depleted.

If a producing well is abandoned, date of last production 19

Was permission obtained from the Conservation Division or
its agents before plugging was commenced? yes

Name of Conservation Agent who supervised plugging of this well Owens
Producing formation Depth to top Bottom Total Depth of Well 3020
Show depth and thickness of all water, oil and gas formations.

OIL, GAS OR WATER RECORDS

CASING RECORD

FORMATION	CONTENT	FROM	TO	SIZE	PUT IN	PULLED OUT
				8 10-3/4	312	none
				5 1/2"	3005	1993'

Describe in detail the manner in which the well was plugged, indicating where the mud fluid
was placed and the method or methods used in introducing it into the hold. If cement or other
plugs were used, state the character of same and depth placed, from feet to
feet for each plug-set.

Sanded to 2625'. Shot pipe at 2019', 1987', pulled 65 joints. Pumped
5 sacks hulls, 17 sacks gel, 150 sacks 50/50 pos mix, 2% gel.

PLUGGING COMPLETE.

RECEIVED
JUN 06 1978
WICHITA, KANSAS

(If additional description is necessary, use BACK of this sheet)

Name of Plugging Contractor VOTH CASING PULLING
CHASE, KANSAS

STATE OF KANSAS COUNTY OF RICE, ss.
WALTER VOTH (employee of owner) or (owner or operator)
of the above-described well, being first duly sworn on oath, says: That I have knowledge of
the facts, statements, and matters herein contained and the log of the above-described well
as filed and that the same are true and correct. So help me God.

(Signature)

CHASE, KANSAS

(Address)

SUBSCRIBED AND SWORN TO before me this 31st day of May, 1978

Margaret Melcher

Notary Public.

My commission expires

