

STATE OF KANSAS  
STATE CORPORATION COMMISSION

WELL PLUGGING RECORD

Give All Information Completely  
Make Required Affidavit  
Mail or Deliver Report to:  
Conservation Division  
State Corporation Commission  
800 Bitting Building  
Wichita, Kansas

Pratt County. Sec. 35 Twp. 27 Rge. (E) 12 (W)

Location as "NE/CNW/SW" or footage from lines SE SE NW

Lease Owner Ambassador Oil and Gas Company

Lease Name Hamm Well No. 1

Office Address P. O. Box 270, Midland, Texas

Character of Well (completed as Oil, Gas or Dry Hole) Dry Hole

Date well completed October 29, 19 53

Application for plugging filed October 29, 19 53


Application for plugging approved October 29, 19 53

Plugging commenced October 29, 19 53

Plugging completed October 29, 19 53

Reason for abandonment of well or producing formation D & A

NORTH

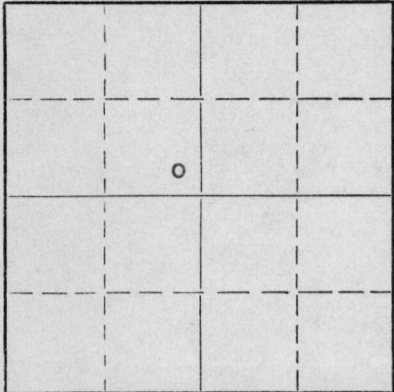

Locate well correctly on above Section Plat

If a producing well is abandoned, date of last production 19

Was permission obtained from the Conservation Division or its agents before plugging was commenced? yes

Name of Conservation Agent who supervised plugging of this well Mr. M. A. Rives, Box 148, Pratt, Kansas

Producing formation Depth to top Bottom Total Depth of Well 4506 Feet

Show depth and thickness of all water, oil and gas formations.

OIL, GAS OR WATER RECORDS

CASING RECORD

FORMATION	CONTENT	FROM	TO	SIZE	PUT IN	PULLED OUT
				13 3/8"	168'	none

Describe in detail the manner in which the well was plugged, indicating where the mud fluid was placed and the method or methods used in introducing it into the hole. If cement or other plugs were used, state the character of same and depth placed, from feet to feet for each plug set.

Filled hole to 300 ft. and dumped 1/2 sack of hulls. Bottom plug at 300 ft. with 50 sx. cement. Filled hole to 20 ft. and dumped 1/2 sk. hulls. Top plug at 20 ft. with 20 sx. cement. Mud to surface. (Plug driven down by Globe Cementing Co.)

(If additional description is necessary, use BACK of this sheet)

Name of Plugging Contractor Graham-Messman-Rinehart Oil Company  
Address P. O. Box 1033, Wichita, Kansas

STATE OF Kansas, COUNTY OF Sedgwick, ss. J. A. Gilliland (contractor)

well, being first duly sworn on oath, says: That I have knowledge of the facts, statements, and matters herein contained and the log of the above-described well as filed and that the same are true and correct. So help me God.

(Signature) J. A. Gilliland  
1005 E. Second Street, Wichita, Kansas (Address)

SUBSCRIBED AND SWORN TO before me this 4th day of November, 19 53

My commission expires December 1, 1956  
Barbara J. Scott Notary Public.

PLUGGING  
FILE SEC 35 T 27 R 12W  
BOOK PAGE 140 LINE 4

WELL RECORD

Location: SE SE NW 35-27-12  
Pratt County, Kansas

Commenced: October 11, 1953

Completed: October 29, 1953

Operator: Hamilton Brothers  
Box 270, Midland, Texas

Elevation: 1757 K.B.

Contractor: Graham-Messman-Rienhart Oil Co.  
1005 E. Second St., Wichita, Kansas

Production: D & A

Casing Record: 13 3/8" @ 168' with 205 ex. cem.

LOG

Sand & Clay	141
Shale	192
Shale	598
Shale	1240
Shale & Shells	1685
Shale & Shells	1860
Lime Shale	2070
Lime Shale	2190
Shale Lime	2340
Lime Shale	2481
Lime Shale	2616
Shale Lime	2766
Lime Shale	2853
Lime Shale	2971
Shale Lime	3183
Lime Shale	3385
Shale Lime	3480
Lime Shale	3601
Lime	3665
Lime	3695
Lime	3716
Lime	3770
Lime	3811
Lime	3850
Lime	3900
Lime	3934
Lime	3942
Lime	3950
Lime	3987
Lime	4026
Lime Shale	4040
Lime Shale	4075
Lime Chert	4105
Lime Chert	4120
Lime	4153
Lime Chert	4170
Lime	4199

Lime Shale	4258
Chert Lime	4270
Lime Chert	4302
Lime Chert	4327
Lime Chert	4337
Lime Chert	4371
Sand - Shale	4384
Simpson	4402
Simpson	4420
Simpson	4457
Arbuckle	4479
Arbuckle	4506 T.D.

TOPS

3402 - Heebner (-1645)
3434 - Douglas Sand (-1677)
3592 - Brown Lime (-1835)
3610 - Lansing (-1853)
4061 - Mississippi (-2304)
4196 - Kinderhook (-2493)
4262 - Viola (-2505)
4357 - Simpson Sh. (-2600)
4363 - Simpson Sd. (-2606)
4456 - Arbuckle (-2701)

The undersigned, GRAHAM-MESSMAN-RINEHART OIL COMPANY, hereby certifies that the above log is a true and correct log of the formation encountered in drilling the above well as reflected by the Daily Drilling Reports.

GRAHAM-MESSMAN-RINEHART OIL COMPANY

By: J. A. Gilliland  
J. A. Gilliland

Subscribed and sworn to before me this  
4th day of November, 1953

Richard J. Shea  
Notary Public

My commission expires: December 1, 1956

PLUGGING  
FILE SEC 35-27-R-126  
BOOK PAGE 140 LINE 2