


WELL PLUGGING RECORD

Give All Information Completely
Make Required Affidavit
Mail or Deliver Report to:
Conservation Division
State Corporation Commission
211 No. Broadway
Wichita, Kansas

NORTH

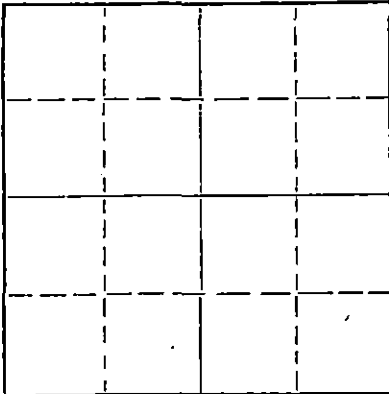

Locate well correctly on above
Section Plat

Pratt County, Sec. 35 Twp. 27S Rge. 12 (W)
Location as "NE/CNW/SW" or footage from lines. SE SE NW
Lease Owner Bowers Drilling Company, Inc.
Lease Name Hamm (Washdown) Well No. 1
Office Address 416 Union Center, Wichita, Kansas
Character of Well (completed as Oil, Gas or Dry Hole) Dry Hole
Date well completed November 5 19 63
Application for plugging filed November 5 19 63
Application for plugging approved November 5 19 63
Plugging commenced November 5 19 63
Plugging completed November 5 19 63
Reason for abandonment of well or producing formation Dry hole

If a producing well is abandoned, date of last production 19
Was permission obtained from the Conservation Division or its agents before plugging was commenced? Yes, verbally

Name of Conservation Agent who supervised plugging of this well

Producing formation Depth to top Bottom Total Depth of Well 4533 Feet

Show depth and thickness of all water, oil and gas formations.

OIL, GAS OR WATER RECORDS

CASING RECORD

FORMATION	CONTENT	FROM	TO	SIZE	PUT IN	PULLED OUT
				805/8"	168'	
					(old well)	

Describe in detail the manner in which the well was plugged, indicating where the mud fluid was placed and the method or methods used in introducing it into the hole. If cement or other plugs were used, state the character of same and depth placed, from feet to feet for each plug set.

Filled with heavy mud to 200'
Set first plug at 200' w/50 sax

Filled with heavy mud to 40'
Set second plug at 40' w/20 sax

RECEIVED
STATE CORPORATION COMMISSION

NOV 12 1963

CONSERVATION DIVISION
Wichita, Kansas

(If additional description is necessary, use BACK of this sheet)
Name of Plugging Contractor Bowers Drilling Company, Inc.
Address 416 Union Center, Wichita, Kansas

STATE OF KANSAS, COUNTY OF SEDGWICK, ss.

Emil E. Bowers

Emil E. Bowers (owner or operator) of the above-described well, being first duly sworn on oath, says: That I have knowledge of the facts, statements, and matters herein contained and the log of the above-described well as filed and that the same are true and correct. So help me God.

(Signature)

Emil E. Bowers

416 Union Center, Wichita, Kansas

(Address)

SUBSCRIBED AND SWORN to before me this 11th day of November, 19 63

Hanna J. Miller

My commission expires May 1, 1966

Notary Public.