


WELL PLUGGING RECORD

Give All Information Completely
Make Required Affidavit
Mail or Deliver Report to:
Conservation Division
State Corporation Commission
212 No. Market
Wichita, Kansas

NORTH

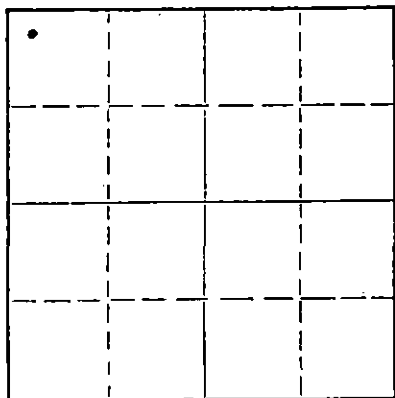

Locate well correctly on above
Section Plat

Pratt County, Sec. 4, Twp. 27 Rge. (E) 13 (W)
Location as "NE/CNW/SW" or footage from lines NW NW NW
Lease Owner The Bovaird Supply Company
Lease Name Chance Well No. 1
Office Address P.O. Box 2590, Tulsa, Oklahoma
Character of Well (completed as Oil, Gas or Dry Hole) oil
Date well completed 19
Application for plugging filed July 28 19 69
Application for plugging approved 19
Plugging commenced August 12 19 69
Plugging completed August 16 19 69
Reason for abandonment of well or producing formation depleted

If a producing well is abandoned, date of last production 19
Was permission obtained from the Conservation Division or its agents before plugging was commenced? yes

Name of Conservation Agent who supervised plugging of this well Ralph Warren
Producing formation Depth to top Bottom Total Depth of Well 4485 Feet
Show depth and thickness of all water, oil and gas formations.

OIL, GAS OR WATER RECORDS

CASING RECORD

FORMATION	CONTENT	FROM	TO	SIZE	PUT IN	PULLED OUT
		0	310'	8 5/8"	310'	none
		0	4485'	5 1/2"	4485'	3135.88

Describe in detail the manner in which the well was plugged, indicating where the mud fluid was placed and the method or methods used in introducing it into the hole. If cement or other plugs were used, state the character of same and depth placed, from feet to feet for each plug set.

Sanded back to 4420' and dumped 5 sacks of cement.

Squeezed well with 15 sacks mud and 75 sacks cement. Cap well.

RECEIVED
STATE CORPORATION COMMISSION
AUG 29 1969
CONSERVATION DIVISION
Wichita, Kansas

(If additional description is necessary, use BACK of this sheet)
Name of Plugging Contractor PIPE PULLERS, INC.
Address Box 486, Ellinwood, Kansas

STATE OF Kansas, COUNTY OF Barton, ss.
Evelyn Roth (employee of owner) or (owner or operator) of the above-described well, being first duly sworn on oath, says: That I have knowledge of the facts, statements, and matters herein contained and the log of the above-described well as filed and that the same are true and correct. So help me God.

(Signature) Evelyn Roth
Ellinwood, Kansas (Address)

SUBSCRIBED AND SWORN TO before me this 28th day of August, 19 69

My commission expires Feb. 10, 1971
Serge A. Meyer Notary Public

WELL LOG BUREAU - KANSAS GEOLOGICAL SOCIETY
412 Union National Bk. Bldg., Wichita, Kansas


COPY

Company - LION CHEMICAL CORP.
Farm - Chance No. 1

SEC. 4 T. 27 R. 13 W
NW6 NW

Total Depth. 4485'
Comm. 7-13-46 Comp. 8-2-46
Shot or Treated.
Contractor. R. W. Line Drig. Co.
Issued. 1-4-47

County. Pratt
KANSAS

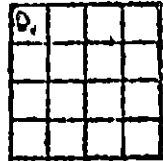

CASING:
8 5/8" 310' Cem.
5 1/8" 4485' Cem.

Elevation. _____

Production. Phy. Pot. 203 plus
5% Wtr.

Figures Indicate Bottom of Formations.

clay	0-10
sand & clay	167
sand & shale	310
red rock & shale	570
shale & shells	855
anhydrite	890
shale & shells	1975
lime & shale	2815
shale	3065
lime & shale	4242
lime	4270
lime & shale	4295
lime	4355
shale & shells	4385
shale	4430
shale & lime	4475
lime	4485
Total Depth.	

Tops:	
Lansing	3787
Mississippian	4212
Kinderhook	4228
Viola	4247
Simpson	4332
Arbuckle	4432

Perf. 36/4432-40'
3000 acid

RECEIVED
STATE CORPORATION COMMISSION
JUL 29 1969
CONSERVATION DIVISION
Wichita, Kansas