


Give All Information Completely
Make Required Affidavit
Mail or Deliver Report to:
Conservation Division
State Corporation Commission
212 No. Market
Wichita, Kansas

WELL PLUGGING RECORD

Pratt County, Sec. 4 Twp. 27 Rge. (E) 13(W)

Location as "NE/CNW/SW" or footage from lines C E/2 NW NW
Lease Owner The Bovaird Supply Company
Lease Name Chance Well No. 2
Office Address P.O. Box 2590, Tulsa, Oklahoma
Character of Well (completed as Oil, Gas or Dry Hole) oil
Date well completed 19
Application for plugging filed November 18 1969
Application for plugging approved 19
Plugging commenced November 20 1969
Plugging completed November 29 1969
Reason for abandonment of well or producing formation depleted

NORTH

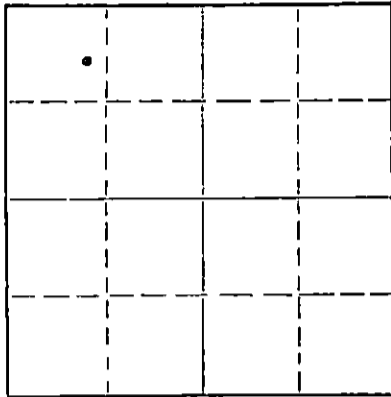

Locate well correctly on above Section Plat

If a producing well is abandoned, date of last production 19
Was permission obtained from the Conservation Division or its agents before plugging was commenced? yes

Name of Conservation Agent who supervised plugging of this well Ralph Warren
Producing formation Depth to top Bottom Total Depth of Well 4442 Feet
Show depth and thickness of all water, oil and gas formations.

OIL, GAS OR WATER RECORDS

CASING RECORD

FORMATION	CONTENT	FROM	TO	SIZE	PUT IN	PULLED OUT
		0	805'	8 5/8"	805'	none
		0	4437'	5 1/2"	4437'	2746.48

Describe in detail the manner in which the well was plugged, indicating where the mud fluid was placed and the method or methods used in introducing it into the hole. If cement or other plugs were used, state the character of same and depth placed, from feet to feet for each plug set.

Sanded back to 4430' and dumped 5 sacks of cement.

Squeezed well with 15 sacks mud and 75 sacks of cement.

RECEIVED
STATE CORPORATION COMMISSION
DEC 9 1969
CONSERVATION DIVISION
Wichita, Kansas

(If additional description is necessary, use BACK of this sheet)
Name of Plugging Contractor PIPE PULLERS, INC.
Address Box 486, Ellinwood, Kansas

STATE OF Kansas, COUNTY OF Barton, ss.
Evelyn Roth (employee of owner) or (owner or operator) of the above-described well, being first duly sworn on oath, says: That I have knowledge of the facts, statements, and matters herein contained and the log of the above-described well as filed and that the same are true and correct. So help me God.

(Signature) Evelyn Roth
Ellinwood, Kansas (Address)

SUBSCRIBED AND SWORN to before me this 8th day of December, 1969

My commission expires Feb. 10, 1971

George A Meyer Notary Public.

WELL LOG BUREAU -- KANSAS GEOLOGICAL SOCIETY
412 Union National Bk. Bldg., Wichita, Kansas


COPY

Company - LION CHEMICAL CORPORATION
Farm - Chance No. 2

SEC. 4 T. 27 R. 13W
CE/2 NW NW

Total Depth. 4442'
Comm. 11-23-46 Comp. 12-10-46
Shot or Treated. Acid. w/1000 gals.
Contractor. The R. W. Rine Drlg. Co.
Issued. 1-25-47

County. Pratt KANSAS

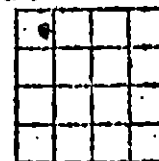

CASING:
8-5/8" 805' Cem
5-1/2" 4437' Cem

Elevation. _____

Production. Pot. 264 bbls.

Figures Indicate Bottom of Formations.

clay & sand	0-40
sand	245
red shale & shells	360
sand, shells & red bed	806
sand, shale, shells	1350
shale & shells	1997
limo & shale	2125
shells & shale	2255
limo & shale	2440
shale & shells	2545
limo & shale	2745
shale & shells	2870
limo & shale	3773
limo	3828
limo & shale	3952
lime	4024
limo & shale	4090
lime	4334
shale	4338
shale & sand	4395
shale	4436
lime	4442
Total Depth	
Tops:	
Lansing	3796
Viola	4255
Simpson	4335
Arbuckle	4436

RECEIVED
STATE CORPORATION COMMISSION
JUL 29 1969
CONSERVATION DIVISION
Wichita, Kansas