


Give All Information Completely
Make Required Affidavit
Mail or Deliver Report to:
Conservation Division
State Corporation Commission
212 No. Market
Wichita, Kansas

WELL PLUGGING RECORD

Pratt County. Sec. 4 Twp. 27 Rge. (E) 13(W)

Location as "NE/CNW/SW" or footage from lines NW NE NW
Lease Owner The Bovaird Supply Company
Lease Name Chance Well No. 3
Office Address P.O. Box 2590, Tulsa, Oklahoma
Character of Well (completed as Oil, Gas or Dry Hole) oil
Date well completed _____ 19____
Application for plugging filed November 18 1969
Application for plugging approved _____ 19____
Plugging commenced November 25 1969
Plugging completed November 29 1969
Reason for abandonment of well or producing formation depleted

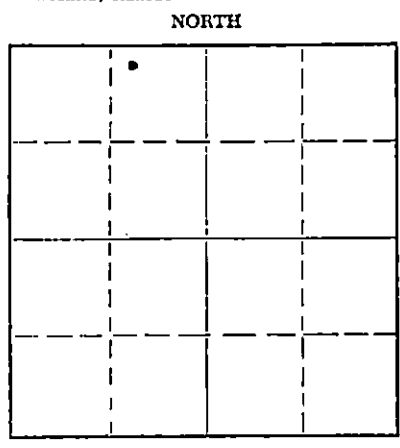

If a producing well is abandoned, date of last production _____ 19____
Was permission obtained from the Conservation Division or its agents before plugging was commenced? yes

Name of Conservation Agent who supervised plugging of this well Ralph Warren
Producing formation _____ Depth to top _____ Bottom _____ Total Depth of Well 4444 Feet
Show depth and thickness of all water, oil and gas formations.

OIL, GAS OR WATER RECORDS

CASING RECORD

FORMATION	CONTENT	FROM	TO	SIZE	PUT IN	PULLED OUT
		0	805'	8 5/8"	805'	none
		0	4440'	5 1/2"	4440'	1460.19

Describe in detail the manner in which the well was plugged, indicating where the mud fluid was placed and the method or methods used in introducing it into the hole. If cement or other plugs were used, state the character of same and depth placed, from _____ feet to _____ feet for each plug set.

Sanded back to 4430' and dumped 5 sacks of cement.

Squeezed well with 15 sacks mud and 75 sacks of cement.

RECEIVED
STATE CORPORATION COMMISSION
DEC 1 1 1969
CONSERVATION DIVISION
Wichita, Kansas

(If additional description is necessary, use BACK of this sheet)
Name of Plugging Contractor PIPE PULLERS, INC.
Address Box 486, Ellinwood, Kansas

STATE OF Kansas, COUNTY OF Barton, ss.
Evelyn Roth (employee of owner) or (owner or operator) of the above-described

well, being first duly sworn on oath, says: That I have knowledge of the facts, statements, and matters herein contained and the log of the above-described well as filed and that the same are true and correct. So help me God.

(Signature) Evelyn Roth
Ellinwood, Kansas
(Address)

SUBSCRIBED AND SWORN to before me this 8th day of December, 1969

George A. Meyer
Notary Public

My commission expires Feb. 10, 1971

WELL LOG BUREAU-- KANSAS GEOLOGICAL SOCIETY
412 Union National Bk. Bldg., Wichita, Kansas


COPY

Company - LION CHEMICAL CORPORATION
Farm - Chance No. 3

SEC. 4 T. 27 R. 13W
NW NE NW

Total Depth. 4444'
Comm. 12-13-46 Comp. 12-27-46
Shot or Treated. Acidized w/1000 gals.
Contractor. The R. W. Rine Drlg. Co.
Issued. 2-15-47

County. Pratt KANSAS

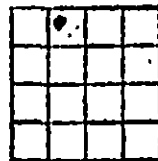

Elevation. _____

Production. Phy. Pot. 256 oil
Plus 1% water

Figures indicate Bottom of Formations.

sand, clay & red bed	0-167
sand & red bed	560
shale & shells	900
sand, shells & shale	1554
shale & shells	1800
shale & lime	1980
shale & shells	2305
lime & shale	3520
shale	3605
lime & shale	3720
lime	3785
lime & shale	3919
lime	3983
lime & shale	4199
lime	4340
lime & shale	4347
sand	4352
sand & shale	4373
lime & shale	4430
shale	4438
lime	4444
Total Depth	

Tops:	
Lansing	3791
Viola	4273
Simpson Shale	4339
Simpson Sand	4345
Arbuckle	4439

Pump 15 OPH
Acidized w/1000 gals.

RECEIVED
STATE CORPORATION COMMISSION
JUL 29 1969
CONSERVATION DIVISION
Wichita, Kansas