

STATE OF KANSAS
STATE CORPORATION COMMISSION

Give All Information Completely
Make Required Affidavit
Mail or Deliver Report to:
Conservation Division
State Corporation Commission
800 Bitting Building
Wichita, Kansas

WELL PLUGGING RECORD

Pratt

County. Sec. 5 Twp. 27S Rge. 13W (E) (W)

Location as "NE/CNW%SW%" or footage from lines SW NW SE

Lease Owner R. W. Rine Drilling Company

Lease Name Phillips "B" Well No. 1

Office Address 320 Central Bldg. - Wichita, Kansas

Character of Well (completed as Oil, Gas or Dry Hole) Oil

Date well completed May 13, 1955

Application for plugging filed February 22, 1956

Application for plugging approved February 23, 1956


Plugging commenced March 1, 1956

Plugging completed March 3, 1956

Reason for abandonment of well or producing formation non-commercial

If a producing well is abandoned, date of last production 19

Was permission obtained from the Conservation Division or its agents before plugging was commenced? Yes

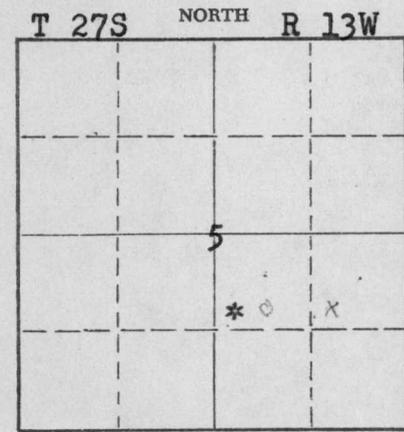

Locate well correctly on above Section Plat

Name of Conservation Agent who supervised plugging of this well Merle Rives

Producing formation _____ Depth to top _____ Bottom _____ Total Depth of Well 4487 Feet

Show depth and thickness of all water, oil and gas formations.

OIL, GAS OR WATER RECORDS

CASING RECORD

FORMATION	CONTENT	FROM	TO	SIZE	PUT IN	PULLED OUT
				8-5/8"	868'	None
				5-1/2"	4487'	3221'
				Pipe perforated from 3310' to 4280'. Hole plugged back to 4300'.		

Describe in detail the manner in which the well was plugged, indicating where the mud fluid was placed and the method or methods used in introducing it into the hole. If cement or other plugs were used, state the character of same and depth placed, from _____ feet to _____ feet for each plug set.

Filled the hole with sand from 4300' to 3300' and ran 5 sacks of cement. Pulled the casing out and pumped in 30 sacks of jall mud and 100 sacks of cement to fill surface casing to base of cellar. Plugging completed.

(If additional description is necessary, use BACK of this sheet)

Name of Plugging Contractor West Supply Co., Inc.
Address Chase, Kansas

STATE OF KANSAS, COUNTY OF SEDGWICK, ss.
E. H. SLOYER (employee of owner) or (~~owner or operator~~) of the above-described well, being first duly sworn on oath, says: That I have knowledge of the facts, statements, and matters herein contained and the log of the above-described well as filed and that the same are true and correct. So help me God.

(Signature) E. H. Sloyer
E. H. Sloyer
320 Central Building, Wichita, Kansas
(Address)

SUBSCRIBED AND SWORN TO before me this 12th day of March 19 56.

My commission expires June 14, 1958.

Loren E. Lake Notary Public.

PLUGGING
FILE SEC 5 T 27 R 13W
BOOK PAGE 40 LINE 30

RECEIVED
STATE CORPORATION COMMISSION
MAR 13 1956
3-13-56
CONSERVATION DIVISION
Wichita, Kansas