

CARD MUST BE TYPED

State of Kansas  
**NOTICE OF INTENTION TO DRILL**  
(see rules on reverse side)

CARD MUST BE SIGNED

Starting Date: April 1, 1985  
month day year

API Number 15-

151-21,592-00-00

OPERATOR: License # 9882

NW NW NE ... Sec 8 ... Twp 27 S, Rge 12  East  
(location)  West

Name Leasing & Development, Inc.

Address One Twenty Building, Suite 501

City/State/Zip Wichita, Kansas 67202

Contact Person Toby Elster

Phone 316-263-0542

4950 ... Ft North from Southeast Corner of Section

2310 ... Ft West from Southeast Corner of Section

(Note: Locate well on Section Plat on reverse side)

CONTRACTOR: License # 5929

Name Duke Drilling, Inc.

City/State Wichita, Kansas

Nearest lease or unit boundary line 330 feet.

County Pratt

Lease Name Studer Well# 1

Domestic well within 330 feet:  yes  no

Municipal well within one mile:  yes  no

Well Drilled For: Well Class: Type Equipment:

Oil  Swd  Infield  Mud Rotary

Gas  Inj  Pool Ext.  Air Rotary

OWWO  Expl  Wildcat  Cable

Depth to Bottom of fresh water ~~230~~ 230 feet

Lowest usable water formation .....

Depth to Bottom of usable water 250 feet

Surface pipe by Alternate: 1  2

Surface pipe to be set 250 feet

Conductor pipe if any required .....

Ground surface elevation Est. 1880 feet MSL

This Authorization Expires 9-15-85

Approved By 3-15-85 *[Signature]*

I certify that we will comply with K.S.A. 55-101, et seq., plus eventually plugging hole to K.C.C. specifications.

Date March 14, 1985 Signature of Operator or Agent *[Signature]*


Title Sec-Treas.

KDR-KDHE 3-15-85 Form C-1 4/84

Must be filed with the K.C.C. five (5) days prior to commencing well  
This card void if drilling not started within six (6) months of date received by K.C.C.

**Important procedures to follow :**

**A Regular Section of Land**  
**1 Mile = 5,280 Ft.**

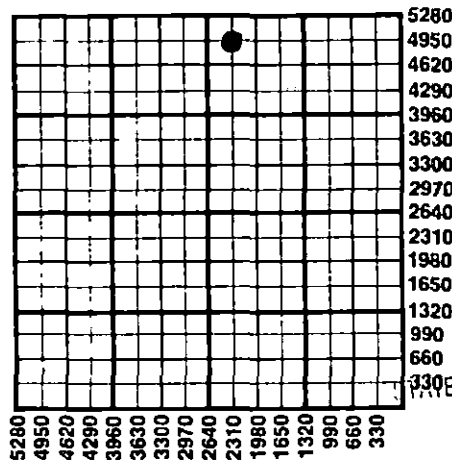

1. Notify District office before setting surface casing.
2. Set surface casing by circulating cement to the top.
3. File completion forms ACO-1 with K.C.C. within 90 days of well completion, following instructions on ACO-1, side 1, and including copies of wireline logs.
4. Notify District office 48 hours prior to old well workover or re-entry.
5. Prior to plugging, prepare a plugging plan, then obtain agreement from the appropriate district office for an approved plugging plan.
6. Submit plugging report (CP-4) to K.C.C. after plugging is completed.
7. Obtain an approved injection docket number before disposing of salt water.
8. Notify K.C.C. within 10 days when injection commences or terminates.
9. If an alternate 2 completion, cement in the production pipe from below any usable water to surface within 120 days of spud date.

RECEIVED  
STATE CORPORATION COMMISSION  
MAR 15 1985  
CONSERVATION DIVISION  
Wichita, Kansas

State Corporation Commission of Kansas  
Conservation Division  
200 Colorado Derby Building  
Wichita, Kansas 67202  
(316) 263-3238