

CARD MUST BE TYPED

State of Kansas
NOTICE OF INTENTION TO DRILL
(see rules on reverse side)

CARD MUST BE SIGNED

Starting Date: 11 01 85
month day year

API Number 15- 151-21,736-00-00
NE SE NE Sec 8 Twp 27 S, Rge 12 East
(location) West

OPERATOR: License # 9158
Name Case Oil & Gas, Inc.
Address 110 S. Main, P.O. Box 8564
City/State/Zip Pratt, KS 67124
Contact Person Stan. Case
Phone (316) 672-9347

3630 Ft North from Southeast Corner of Section
330 Ft West from Southeast Corner of Section
(Note: Locate well on Section Plat on reverse side)

CONTRACTOR: License # 5829
Name Aldebaran Drilling Co., Inc.
City/State Pratt, KS 67124

Nearest lease or unit boundary line 330 feet.
County Pratt
Lease Name Grizzly Well# 1
Domestic well within 330 feet: yes no
Municipal well within one mile: yes no

Well Drilled For: Well Class: Type Equipment:
 Oil Swd Infield Mud Rotary
 Gas Inj Pool Ext. Air Rotary
 OWWO Expl Wildcat Cable

Depth to Bottom of fresh water 185-150 feet
Lowest usable water formation
Depth to Bottom of usable water 185 feet
Surface pipe by Alternate: 1 2
Surface pipe to be set 400 feet
Conductor pipe if any required none feet
Ground surface elevation 1851 feet MSI.
This Authorization Expires 4-25-86
Approved By 10-25-85 *RCM/10/85*

If OWWO: old well info as follows:
Operator
Well Name
Comp Date Old Total Depth
Projected Total Depth 4600 feet
Projected Formation at TD Viola
Expected Producing Formations Mississippi


I certify that we will comply with K.S.A. 55-101, et seq., plus eventually plugging hole to K.C.C. specifications.

Date 10-24-85 Signature of Operator or Agent Joyce Parker Title Office Manager

Must be filed with the K.C.C. five (5) days prior to commencing well
This card void if drilling not started within six (6) months of date received by K.C.C.

Important procedures to follow :

**A Regular Section of Land
1 Mile = 5,280 Ft.**

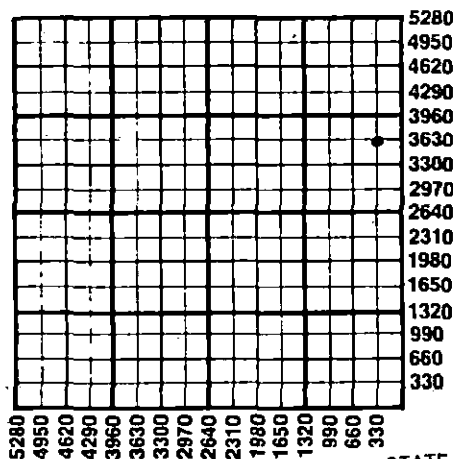

1. Notify District office before setting surface casing.
2. Set surface casing by circulating cement to the top.
3. File completion forms ACO-1 with K.C.C. within 90 days of well completion, following instructions on ACO-1, side 1, and including copies of wireline logs.
4. Notify District office 48 hours prior to old well workover or re-entry.
5. Prior to plugging, prepare a plugging plan, then obtain agreement from the appropriate district office for an approved plugging plan.
6. Submit plugging report (CP-4) to K.C.C. after plugging is completed.
7. Obtain an approved injection docket number before disposing of salt water.
8. Notify K.C.C. within 10 days when injection commences or terminates.
9. If an alternate 2 completion, cement in the production pipe from below any usable water to surface within 120 days of spud date.

RECEIVED
STATE CORPORATION COMMISSION

State Corporation Commission of Kansas
Conservation Division
200 Colorado Derby Building
Wichita, Kansas 67202
(316) 263-3238

OCT 25 1955

CONSERVATION DIVISION
Wichita, Kansas