

CARD MUST BE TYPED

State of Kansas

CARD MUST BE SIGNED

# NOTICE OF INTENTION TO DRILL

(see rules on reverse side)

Expected Spud Date..... April 18, 1987  
month day year 25

API Number 15- 151-21, 83(-00-00)  
85'N & 140'W

OPERATOR: License # 3180  
Name DEUTSCH OIL COMPANY  
Address 2059 Capri  
City/State/Zip Wichita, Kansas 67207  
Contact Person Kent Deutsch  
Phone 316/687-9565

SW SE SE Sec. 5 Twp. 27 S, Rg. 12  
330 415 Ft. from South Line of Section  
330 1130 Ft. from East Line of Section

(Note: Locate well on Section Plat on reverse side)

CONTRACTOR: License # 5929  
Name DUKE DRILLING CO., INC.  
City/State Great Bend, Kansas 67530

Nearest lease or unit boundary line 330 feet  
County Pratt

Lease Name Dikeman Well # 1

Ground surface elevation 1856 feet MSL

Domestic well within 330 feet: yes  no

Municipal well within one mile: yes  no

Depth to bottom of fresh water 180

Depth to bottom of usable water 200

Surface pipe by Alternate: 1  2

Surface pipe planned to be set 350

Conductor pipe required

Projected Total Depth 4500 feet

Formation Arbuckle

Well Drilled For: Well Class: Type Equipment:  
 Oil  Storage  Infield  Mud, Rotary  
 Gas  Inj  Pool Ext.  Air Rotary  
 OWWO  Expl  Wildcat  Cable

If OWWO: old well info as follows:

Operator  
Well Name  
Comp Date Old Total Depth

I certify that well will comply with K.S.A. 55-101, et seq., plus eventually plugging hole to KCC specifications.

Date April 14, 1987. Signature of Operator or Agent *Kent Deutsch* Title Operator

For KCC Use:

Conductor Pipe Required ..... feet; Minimum Surface Pipe Required 220 feet per Alt. 1 ✓


This Authorization Expires 10-15-87 Approved By 4-15-87 *[Signature]*

Must be filed with the K.C.C. five (5) days prior to commencing well  
This card void if drilling not started within six (6) months of date received by K.C.C.

### Important procedures to follow:

1. Notify District office before setting surface casing.
2. Set surface casing by circulating cement to the top.
3. File completion forms ACO-1 with K.C.C. within 120 days of well spud date, following instructions on ACO-1, side 1, and including copies of wireline logs.
4. Notify District office 48 hours prior to old well workover or re-entry.
5. Prior to filing Intent, prepare a proposed plugging plan in case well is D & A, then obtain approval of plan when calling district office prior to setting surface pipe.
6. Submit plugging report (CP-4) to K.C.C. after plugging is completed.
7. Obtain an approved injection docket number before disposing of salt water.
8. Notify K.C.C. within 10 days when injection commences or terminates.
9. If an alternate 2 completion, cement in the production pipe from below any usable water to surface within 120 days of spud date.

### A Regular Section of Land 1 Mile = 5,280 Ft.

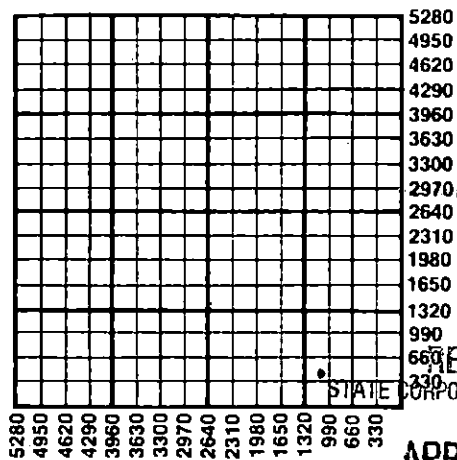

RECEIVED  
STATE CORPORATION COMMISSION

APR 15 1987

CONSERVATION DIVISION  
Wichita, Kansas

State Corporation Commission of Kansas  
Conservation Division  
200 Colorado Derby Building  
Wichita, Kansas 67202-1212  
(316) 263-3238