

CARD MUST BE TYPED

State of Kansas  
**NOTICE OF INTENTION TO DRILL**  
(see rules on reverse side)

CARD MUST BE SIGNED

Starting Date: ...October..15,..1985.....  
month day year

API Number 15- 151-21,704-0000

OPERATOR: License # ..6408.....  
Name W.K. BLACK, INC.....  
Address P.O. BOX 801.....  
City/State/Zip ..PRATT, KANSAS.. 67124.....  
Contact Person WILLIAM K. (BILL) BLACK.....  
Phone ..316-672-5712.....

C. N/2 SW NW/4 Sec 23 .. Twp 27 .. S, Rge 12 ..  East  West  
(location)

.....3630..... Ft North from Southeast Corner of Section  
.....4620..... Ft West from Southeast Corner of Section  
(Note: Locate well on Section Plat on reverse side)

CONTRACTOR: License # ....5829.....  
Name ALDEBARAN DRILLING CO., INC.....  
City/State ..WICHITA, KANSAS.....

Nearest lease or unit boundary line ... 660..... feet.  
County ..PRATT.....

Lease Name ..STUDER..... Well# 1-G

Domestic well within 330 feet :  yes  no

Municipal well within one mile :  yes  no

Well Drilled For: Well Class: Type Equipment:  
 Oil  Swd  Infield  Mud Rotary  
 Gas  Inj  Pool Ext.  Air Rotary  
 OWWO  Expl  Wildcat  Cable

Depth to Bottom of fresh water ... 200..... feet

Lowest usable water formation ..lower K.....

Depth to Bottom of usable water .. 200..... feet

Surface pipe by Alternate : 1  2

Surface pipe to be set ..... 225..... feet

Conductor pipe if any required ..... feet

Ground surface elevation ..1806 (D. 200)..... feet MSL

This Authorization Expires ..3-11-86

Approved By ..9-11-85

If OWWO: old well info as follows:

Operator .....

Well Name .....

Comp Date ..... Old Total Depth .....


Projected Total Depth ..4500..... feet

Projected Formation at TD..... ARBUCKLE.....

Expected Producing Formations SIMP., VIOLA,.....

I certify that we will comply with K.S.A. 55-101, et seq., plus eventually plugging hole to K.C.C. specifications.

Date ..9-9-85..... Signature of Operator or Agent

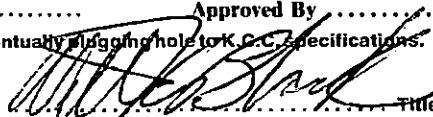


PRESIDENT

Must be filed with the K.C.C. five (5) days prior to commencing well  
This card void if drilling not started within six (6) months of date received by K.C.C.

**Important procedures to follow :**

**A Regular Section of Land  
1 Mile = 5,280 Ft.**

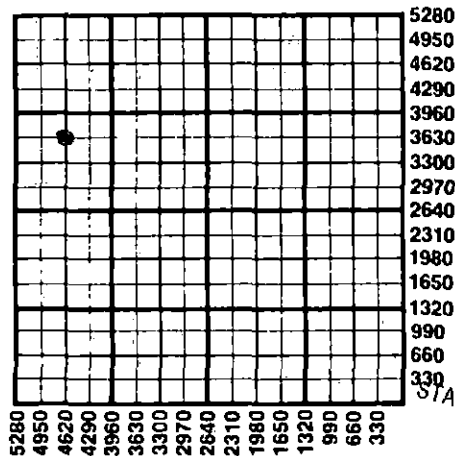

1. Notify District office before setting surface casing.
2. Set surface casing by circulating cement to the top.
3. File completion forms ACO-1 with K.C.C. within 90 days of well completion, following instructions on ACO-1, side 1, and including copies of wireline logs.
4. Notify District office 48 hours prior to old well workover or re-entry.
5. Prior to plugging, prepare a plugging plan, then obtain agreement from the appropriate district office for an approved plugging plan.
6. Submit plugging report (CP-4) to K.C.C. after plugging is completed.
7. Obtain an approved injection docket number before disposing of salt water.
8. Notify K.C.C. within 10 days when injection commences or terminates.
9. If an alternate 2 completion, cement in the production pipe from below now usable water to surface within 120 days of spud date.

RECEIVED  
STATE CORPORATION COMMISSION

SEP 11 1985

CONSERVATION DIVISION  
Wichita, Kansas

State Corporation Commission of Kansas  
Conservation Division  
200 Colorado Derby Building  
Wichita, Kansas 67202  
(316) 263-3238