

STATE OF KANSAS
STATE CORPORATION COMMISSION


Give All Information Completely
Make Required Affidavit
Mud Sliver Report to:
Conservation Division
State Corporation Commission
800 Biting Building
Wichita, Kansas

15-009-06187-0000

WELL PLUGGING RECORD

Barton County, Sec. 8 Twp. 19 Rge. (E) 12 (W)

Location as "NE/CNW $\frac{1}{4}$ SW $\frac{1}{4}$ " or footage from lines 22' west of NW NE SW
 Lease Owner Westgate-Greenland Oil Company
 Lease Name Neeland Well No. 2
 Office Address 1009 Central Building, Wichita 2, Kansas
 Character of Well (completed as Oil, Gas or Dry Hole) dry hole
 Date well completed July 14, 1952 19...
 Application for plugging filed July 14, 1952 (orally) 19...
 Application for plugging approved July 14, 1952 " 19...
 Plugging commenced July 14, 1952 19...
 Plugging completed July 15, 1952 19...
 Reason for abandonment of well or producing formation.....

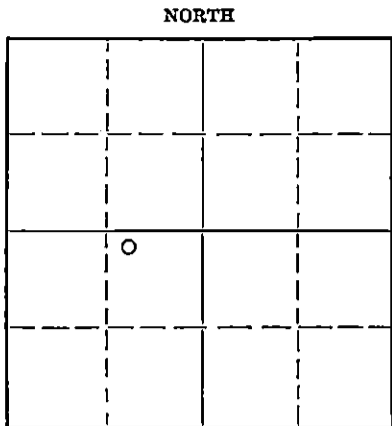

Locate well correctly on above
Section Flat

If a producing well is abandoned, date of last production..... 19...
 Was permission obtained from the Conservation Division or its agents before plugging was commenced? yes

Name of Conservation Agent who supervised plugging of this well M. A. Rives
 Producing formation..... Depth to top..... Bottom..... Total Depth of Well..... Feet

Show depth and thickness of all water, oil and gas formations.

OIL, GAS OR WATER RECORDS

CASING RECORD

Formation	Content	From	To	Size	Put In	Pulled Out
surface		0	200	8 5/8"	200	none

Describe in detail the manner in which the well was plugged, indicating where the mud fluid was placed and the method or methods used in introducing it into the hole. If cement or other plugs were used, state the character of same and depth placed, from..... feet to..... feet for each plug set.

Filled hole with heavy mud from 3433 to 195 feet
Set plug and ran 15 sacks cement 195 to 150'
Filled with heavy mud from 150 to 35 feet
Set plug at 35' and ran 10 sacks cement to cellar.

RECEIVED
STATE CORPORATION COMMISSION
JUL 21 1952
CONSERVATION DIVISION
WICHITA, KANSAS
RCW
07-21-52

Name of Plugging Contractor Jackson Drilling Corporation
 Address 1009 Central Building, Wichita, 2, Kansas

STATE OF Kansas, COUNTY OF Sedgwick, ss.
Harold A. Burt (employee of owner) or ~~owner or operator~~ of the above-described well,

being first duly sworn on oath, says: That I have knowledge of the facts, statements, and matters herein contained and the log of the above-described well as filed and that the same are true and correct. So help me God.

(Signature) Harold A. Burt
1009 Central Building, Wichita 2, Kansas
 (Address)

SUBSCRIBED AND SWORN to before me this 15th day of July 1952

Esther Linsell
 Notary Public.

My commission expires May 25, 1953.

PLUGGING
 FILE SEC 8 T 19 R 12w
 BOOK PAGE 30 LINE 42

DRILLER'S LOG

COMPANY: Westgate-Greenland Oil Company
 CONTRACTOR: Jackson Drilling Corporation
 FARM: Neeland No. 2
 LOCATION: 22 feet west of NW NE SW
 Sec. 8-19-12W, Barton County, Kansas
 COMMENCED: July 4, 1952
 COMPLETED: July 15, 1952
 ELEVATION: 1834 DF

 0 to 180 Shale, shells and clay
 180 to 200 Shale and shells
 200 to 311 Sand and shale
 311 to 960 Shale and shells
 960 to 985 Anhydrite
 985 to 1275 Shale and shells
 1275 to 1390 Salt and shale
 1390 to 1470 Shale and shells
 1470 to 1865 Lime and shale
 1865 to 1890 Lime
 1890 to 2700 Lime and shale
 2700 to 2800 Lime
 2800 to ; 2840 Lime and shale
 2840 to 3058 Lime
 3058 to 3149 Lime and shale
 3149 to 3386 K C Lime
 3386 to 3389 Lime and shale
 3389 to 3395 Lime
 3395 to 3413 Lime and shale-cherty
 3413 to 3433 Arbuckle Lime
 3433 T. D. (RB)

 Set 200 feet of 8 5/8" 24# surface pipe. Cemented with 150 sacks cement and 2 sacks calcium chloride.

Drill Stem Tests: 3151-79, open 1/2 hr, rec. 8' mud, no BHP.
 3182-3228, open 1/2 hr, rec 10' mud,
 weak blow 7 min, no BHP.

TOPS: Anhydrite 960 Brown Lime 3132 Conglomerate 3394
 Heebner 3023 Lansing 3147 Arbuckle 3411
 Toronto 3038 Base K. C. 3386

No Schlumberger run

DRY, PLUGGED AND ABANDONED

 C E R T I F I C A T E

I, Don Allen, do hereby certify that the above and foregoing is a true and correct copy of log of the Neeland No. 2, 22' west of NW NE SW Section 8-19S-12W, Barton County, Kansas, as reflected by files of the Jackson Drilling Corporation.

Don Allen
 Don Allen

Subscribed and sworn to before me, a Notary Public, within and for ~~Sedgewick County~~ Wichita, Kansas, this 18th day of July, 1952. STATE CORPORATION COMMISSION

JUL 21 1952

CONSERVATION DIVISION

Wichita, Kansas
 My commission expires May 25, 1953

Esther Unsell
 Esther Unsell, Notary Public

PLUGGING
 FILE SEC. 8-19-R-12W
 PAGE 30 LINE 42