


Give All Information Completely
Make Required Affidavit
Mail or Deliver Report to:
Conservation Division
State Corporation Commission
800 Bittling Building
Wichita, Kansas

15-009-06082-0000
WELL PLUGGING RECORD

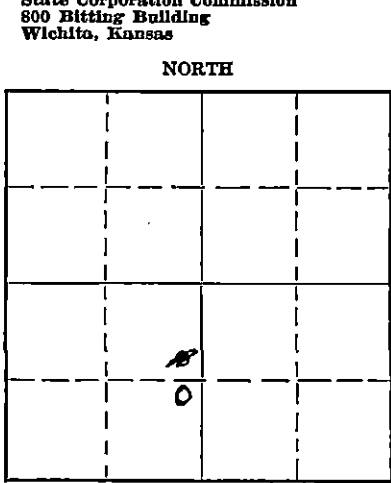

Locate well correctly on above
Section Plat

Barton County. Sec. 8 Twp. 19 Rge. (E) 12 (W)
Location as "NE/CNW $\frac{1}{4}$ SW $\frac{1}{4}$ " or footage from lines SE NE SW NE SE SW
Lease Owner Westgate-Greenland Oil Company
Lease Name Neeland Well No. 1
Office Address 1009 Central Building, Wichita 2, Kansas
Character of Well (completed as Oil, Gas or Dry Hole) dry hole
Date well completed October 24, 1951 19
Application for plugging filed October 24, 1951 19
Application for plugging approved October 25, 1951 19
Plugging commenced October 24, 1951 19
Plugging completed October 24, 1951 19
Reason for abandonment of well or producing formation _____

If a producing well is abandoned, date of last production _____ 19
Was permission obtained from the Conservation Division or its agents before plugging was commenced? yes

Name of Conservation Agent who supervised plugging of this well C. D. Stough
Producing formation _____ Depth to top _____ Bottom _____ Total Depth of Well _____ Feet
Show depth and thickness of all water, oil and gas formations.

OIL, GAS OR WATER RECORDS

CASING RECORD

Formation	Content	From	To	Size	Put In	Pulled Out
Surface		0	266	8 5/8"	266	none

Describe in detail the manner in which the well was plugged, indicating where the mud fluid was placed and the method or methods used in introducing it into the hole. If cement or other plugs were used, state the character of same and depth placed, from _____ feet to _____ feet for each plug set.

Filled hole with heavy mud from total depth 3453 to 240 feet.
Set plug at 240 feet and ran 15 sacks cement.
Filled with heavy mud to 35 feet and set plug.
Ran 10 sacks cement to cellar.

(If additional description is necessary, use BACK of this sheet)

Correspondence regarding this well should be addressed to Westgate-Greenland Oil Company
Address 1009 Central Building, Wichita 2, Kansas

STATE OF Kansas, COUNTY OF Sedgwick, ss.
G. E. Bitler (employee of owner) or (owner or operator) of the above-described well,
being first duly sworn on oath, says: That I have knowledge of the facts, statements, and matters herein contained and the log of the above-described well as filed and that the same are true and correct. So help me God.

(Signature) G. E. Bitler
1009 Central Building, Wichita 2, Kansas
(Address)

SUBSCRIBED AND SWORN to before me this 29th day of October, 19 51
Esther Russell
Notary Public.

My commission expires May 25, 1953.

28-8273-S

PLUGGING
FILE SEC 8 119 R120
BOOK PAGE 119 LINE 27

RECEIVED
OCT 30 1951
CONSERVATION DIVISION
WICHITA, KANSAS

DRILLER'S LOG

COMPANY; Westgate-Greenland Oil Company
 CONTRACTOR: Jackson Drilling Corporation
 FARM: Neeland No. 1
 LOCATION: ~~SE NE SW~~ Sec. 8-19-12W,
 Barton County, Kansas
 COMMENCED: October 13, 1951
 COMPLETED: October 24, 1951
 ELEVATION: 1857 DF

0	to	45	Soil-Clay & Gravel
45	to	143	Shale W/sand streaks
143	to	152	Iron Pyrite and sand
152	to	195	Shale and shells
195	to	227	Pyritic sand
227	to	260	Shale and sand
260	to	264	Pyritic Sand
264	to	380	Shale W/streaks-Pyrite
380	to	707	Red Bed
707	to	733	Anhydrite
733	to	1225	Shale and shells
1225	to	1527	Shale and shells W/ salt
1527	to	2880	Lime and shale
2880	to	3097	Lime
3097	to	3141	Shale and lime
3141	to	3159	Brown Lime
3159	to	3385	Lansing lime
3385	to	3405	Lime and shale
3405	to	3455	Arbuckle
		3455	T. D. (RB)

~~666666~~

Set 266 ft. of ^{8 5/8} 8 5/8" 24# Surface pipe. Cemented with 160 sacks cement and 2 sacks calcium chloride.

Drill Stem Tests: 3161-93, 5' mud in 10 minutes, No. BHP.
 3190-3228, open 1 hr, rec. 840 ft gas, 80 ft gas cuty mud, no BHP.
 3406-14, open 30 min, rec 6 ft mud, no BHP.
 3416-29, open 20 min, rec 30 ft mud, 1100# BHP.

TOPS: Anhydrite 707. Heebneb 3030. Brown Lime 3142.
 Lansing 3157. Arbuckle 3403.

Dry, plugged and abandoned

C E R T I F I C A T E

I, Harold A. Burt, do hereby certify that the above and foregoing is a true and correct copy of log of the Neeland #1, Section 8-19-12W, Barton County, Kansas, as reflected by files of the Jackson Drilling Corporation.

PLUGGING

FILE SEC ~~8-19-12W~~

BOOK PAGE ~~119~~ LINE ~~27~~

Harold A. Burt
 Harold A. Burt.

Subscribed and sworn to before me, a Notary Public, within and for Sedgewick County, Kansas, this 29th day of October, 1951.

OCT 30 1951

CONFIDENTIAL DIVISION

Esther Russell
 Notary Public

My commission expires May 25, 1953.