


STATE OF KANSAS
STATE CORPORATION COMMISSION

15-009-22091-0000

WELL PLUGGING RECORD

Give All Information Completely
Make Required Affidavit
Mail or Deliver Report to
Conservation Division
State Corporation Comm.
245 North Water
Wichita, KS 67202

Barton County, Sec. 22 Twp. 17 Rge. 15 ~~SE~~W
Location as "NE/CNW $\frac{1}{4}$ SW $\frac{1}{4}$ " or footage from lines
SW NE NE
Lease Owner Raymond Oil Co., Inc.
Lease Name HELFRICH Well No. #1
Office Address One Main Place-Suite 900 Wichita, KS 67202
Character of Well (Completed as Oil, Gas or Dry Hole)

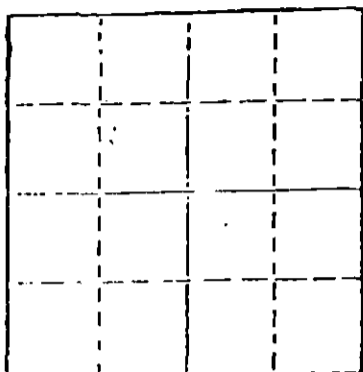

Locate well correctly on above
Section Plot

Date Well completed Oct. 3 1980
Application for plugging filed Oct. 3 1980
Application for plugging approved Oct. 3 1980
Plugging commenced Oct. 3 1980
Plugging completed Oct. 3 1980
Reason for abandonment of well or producing formation

If a producing well is abandoned, date of last production 19

Was permission obtained from the Conservation Division or its agents before plugging was commenced? yes

Name of Conservation Agent who supervised plugging of this well Duane Rankin
Producing formation Depth to top Bottom Total Depth of Well 2865'
Show depth and thickness of all water, oil and gas formations.

OIL, GAS OR WATER RECORDS

CASING RECORD

FORMATION	CONTENT	FROM	TO	SIZE	PUT IN	PULLED OUT

Describe in detail the manner in which the well was plugged, indicating where the mud fluid was placed and the method or methods used in introducing it into the hold. If cement or other plugs were used, state the character of same and depth placed, from feet to feet for each plug set.

Bottom Plug: 30 sacks Thru Drill Pipe of 50/50 pozmix 1% gel, @ 900'
Middle Plug: 30 sacks " " " of " " " @ 330'
Top Plug: @ 40' w/solid bridge of $\frac{1}{2}$ sacks Hulls & 10 sacks cement.
5 sacks in Rat Hole

RECEIVED
STATE CORPORATION COMMISSION
OCT - 8 1980
CONSERVATION DIVISION
Wichita, Kansas

(If additional description is necessary, use BACK of this sheet)
Name of Plugging Contractor Duke Drilling Co., Inc.

STATE OF Kansas COUNTY OF Barton, ss.
Bill Draney (employee of owner) or (owner or operator)
of the above-described well, being first duly sworn on oath, says: That I have knowledge of the facts, statements, and matters herein contained and the log of the above-described well as filed and that the same are true and correct. So help me God.

(Signature) Bill Draney
P.O. Box 823 Great Bend, Kansas 67530
(Address)

SUBSCRIBED AND SWORN TO before me this 6th day of October, 1980

Clara M. Hague
Notary Public.

My commission expires 4-11-1982