


STATE OF KANSAS
STATE CORPORATION COMMISSION

Give All Information Completely
Make Required Affidavit
Mail or Deliver Report to:
Conservation Division
State Corporation Commission
212 No. Market
Wichita, Kansas

15-009-30444-0000 Form CP-4
WELL PLUGGING RECORD

Barton County. Sec. 23 Twp. 17S Rge. (E) 15W (W)
Location as "NE/CNW/SW" or footage from lines NW NE SW
Lease Owner Jay-Bee Oil Company
Lease Name BOOR Well No. 1
Office Address 511 Union Center, Wichita, Kansas 67202
Character of Well (completed as Oil, Gas or Dry Hole) Dry Hole
Date well completed August 22, 1966
Application for plugging filed 19
Application for plugging approved 19
Plugging commenced August 22, 1966
Plugging completed August 22, 1966
Reason for abandonment of well or producing formation _____

NORTH

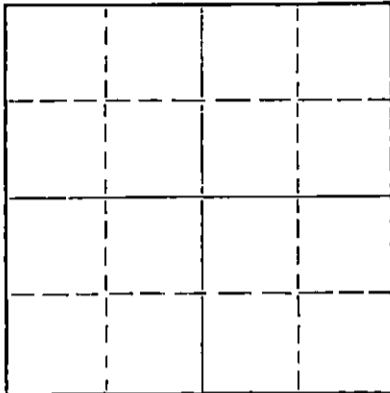

Locate well correctly on above
Section Plat

If a producing well is abandoned, date of last production 19
Was permission obtained from the Conservation Division or its agents before plugging was commenced? Yes (Don Truan)

Name of Conservation Agent who supervised plugging of this well _____
Producing formation _____ Depth to top _____ Bottom _____ Total Depth of Well 3550 Feet
Show depth and thickness of all water, oil and gas formations.

OIL, GAS OR WATER RECORDS

CASING RECORD

FORMATION	CONTENT	FROM	TO	SIZE	PUT IN	PULLED OUT
	Surface	0	279	8-5/8"	8/15/66	----
	Casing					

Describe in detail the manner in which the well was plugged, indicating where the mud fluid was placed and the method or methods used in introducing it into the hole. If cement or other plugs were used, state the character of same and depth placed, from _____ feet to _____ feet for each plug set.

Heavy Mud from Total Depth to 270 Feet; Plug and 25 sacks Cement through the drill pipe; Heavy Mud to 40 feet; Plug and 15 sacks cement to base of cellar; 2 sacks in Rat Hole. Job Completed at 3:15 P.M.

RECEIVED
STATE CORPORATION COMMISSION
AUG 29 1966
CONSERVATION DIVISION
WICHITA, KANSAS
REV
08-30-66

(If additional description is necessary, use BACK of this sheet)

Name of Plugging Contractor Sage Drilling Co., Inc.
Address 500 Bitting Building, Wichita, Kansas

STATE OF KANSAS, COUNTY OF SEDGWICK, ss.
Lawrence F. Gray of Sage Drilling Co., Inc. (employee or owner) or (owner or operator) of the above-described

well, being first duly sworn on oath, says: That I have knowledge of the facts, statements, and matters herein contained and the log of the above-described well as filed and that the same are true and correct. So help me God.

(Signature) Lawrence F. Gray
500 Bitting Building, Wichita, Kansas
(Address)

SUBSCRIBED AND SWORN to before me this 29th day of August, 19 66
Louise K. Whitted
Louise K. Whitted - Notary Public.

My commission expires November 26, 1966

DRILLERS LOG

BOOR NO. 1

CASING RECORD:	COMPANY: Jay-Bee Oil Co.	DESCRIPTION:
8-5/8" @ 279' w/175 sax cement	CONTRACTOR: Sage Drilling Co.	NW NE SW Sec. 23-17S-15W Barton County, Kansas
TOTAL DEPTH: 3550'	COMMENCED: August 15, 1966	ELEVATION: 1974KB
	COMPLETED: August 22, 1966	

<u>FORMATION</u>	<u>FROM</u>	<u>TO</u>	<u>REMARKS</u>
Surface Soil	0	280	
Sand & Shale	280	650	
Shale & Shells	650	1002	
Anhydrite	1002	1031	
Shale & Shells	1031	1275	
Lime & Shale	1275	1915	
Lime	1915	2285	
Lime & Shale	2285	3278	
Lime	3278	3320	
Lime & Shale	3320	3550	

RECEIVED
STATE CORPORATION COMMISSION
AUG 30 1966
CONSERVATION DIVISION
Wichita, Kansas

I certify that this is a true and correct copy of the above log to the best of my knowledge.

SAGE DRILLING COMPANY, INC.

By Lawrence F. Gray
Lawrence F. Gray

Subscribed and sworn to before me this 29th day of August, 1966.

Louise K. Whitted
Louise K. Whitted, Notary Public

My commission expires:
November 26, 1966.