


Give All Information Completely
Make Required Affidavit
Mail or Deliver Report to:
Conservation Division
State Corporation Commission
212 North Market, Insurance Bldg.
Wichita, Kansas

BARTON County, Sec. 11 Twp. 17 Rge. 15 (E) (W)

Location as "NE/CNW&SW" or footage from lines SE SW SW
Lease Owner Three G Oil, Inc.
Lease Name MAX MATER Well No. 4
Office Address Wichita, Kansas
Character of Well (completed as Oil, Gas or Dry Hole) Dry Hole
Date well completed May 6 19 66
Application for plugging filed May 6 19 66
Application for plugging approved May 6 19 66
Plugging commenced May 6 19 66
Plugging completed May 6 19 66
Reason for abandonment of well or producing formation Dry Hole

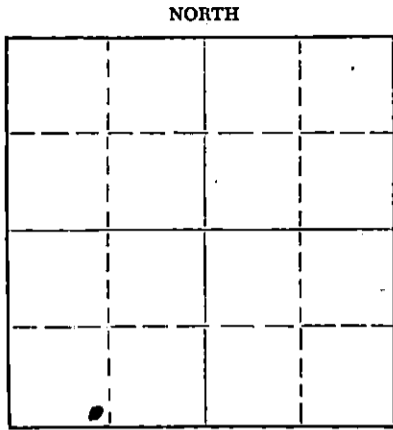

Locate well correctly on above Section Plat

If a producing well is abandoned, date of last production 19
Was permission obtained from the Conservation Division or its agents before plugging was commenced? Yes

Name of Conservation Agent who supervised plugging of this well Don Truan
Producing formation Depth to top Bottom Total Depth of Well Feet
Show depth and thickness of all water, oil and gas formations.

OIL, GAS OR WATER RECORDS

CASING RECORD

FORMATION	CONTENT	FROM	TO	SIZE	PUT IN	PULLED OUT

Describe in detail the manner in which the well was plugged, indicating where the mud fluid was placed and the method or methods used in introducing it into the hole. If cement or other plugs were used, state the character of same and depth placed, from feet to feet for each plug set.

Set plug and 1/4 sack hulls and 25 sacks cement through drill pipe at 900'.

Set plug and 1/4 sack hulls and 25 sack cement through drill pipe at 300'.

Set plug and 1/2 sack hulls and 10 sacks cement at 40'.

RECEIVED
STATE CORPORATION COMMISSION

JUN - 7 1966

CONSERVATION DIVISION
Wichita, Kansas

Name of Plugging Contractor Burt Drilling Co.
Address Great Bend, Kansas 67530

STATE OF KANSAS COUNTY OF BARTON ss.
Duke C. Burt

(employee of owner) or (owner or operator) of the above-described well, being first duly sworn on oath, says: That I have knowledge of the facts, statements, and matters herein contained and the log of the above-described well as filed and that the same are true and correct. So help me God.

(Signature) *Duke C. Burt*
Great Bend, Kansas

(Address)

SUBSCRIBED AND SWORN TO before me this 23rd day of May, 19 66

Dexter Miner

Notary Public.

My commission expires Oct. 15, 1967



THREE G OIL, INC.
 Suite 1101 Wichita Plaza
 Wichita, Kansas

Well: Max Mater No. 4
 Commenced R. D.: 3/26/66
 Completed R. D.: 5/7/66
 Total Depth 3560' D. F.
 Casing: 8 5/8' 8rd thd.
 Surface Pipe

Sec.: 11-17S-15W
 Barton County, Kansas
 Elevation:
 Initial Prod.:
 Contractor: BURT DRILLING
 COMPANY

Strata	Depth
Post Rock	0 - 40'
Shale & Shells	40 - 490
Sand	490 - 620
Shale & Shells	620 - 650
Redbed & Shale	650 - 1009
Anhydrite	1009 - 1030
Shale & Shells	1030 - 1434
Shale & Lime	1434 - 1730
Lime w/Shale Streaks	1730 - 1990
Lime	1990 - 2160
Lime & Shale	2160 - 2322
Shale & Lime Streaks	2322 - 2825
Shale & Lime	2825 - 2915
Lime	2915 - 3191
Heebner	3191 - 3195
Lime & Shale (Toronto 3210-22')	3195 - 3256
Lime	3256 - 3482
Conglomerate	3482 - 3540
Lime (Arbuckle)	3540 - 3560

RECEIVED
 STATE CORPORATION COMMISSION
 JUN - 7 1966
 CONSERVATION DIVISION
 Wichita, Kansas

I hereby certify that the above is a true and correct log of said well as reflected by daily reports.

BURT DRILLING CO.

[Signature]

Signed and sworn in my presence this 9th day of May, 1966.

[Signature]

My Commission Expires: July 2, 1968