


Give All Information Completely  
Make Required Affidavit  
Mail or Deliver Report to:  
Conservation Division  
State Corporation Commission  
212 North Market, Insurance Bldg.  
Wichita, Kansas

15-009 - 30500-0000  
**WELL PLUGGING RECORD**

NORTH

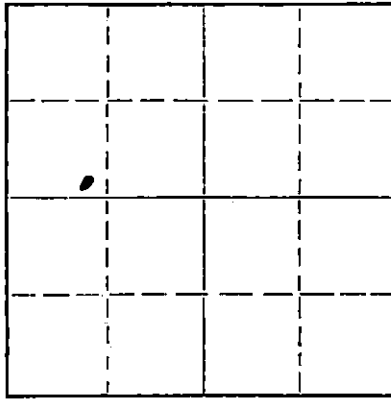

Locate well correctly on above Section Flat

Barton County. Sec. 11 Twp. 17 Rge. 15 (W) (W)  
Location as "NE/CNW/SW" or footage from lines SE SW NW  
Lease Owner R. G. Smith  
Lease Name Mater Well No. 1  
Office Address Rule Building, Wichita, Kansas  
Character of Well (completed as Oil, Gas or Dry Hole) Dry Hole  
Date well completed August 22 19 66  
Application for plugging filed August 22 19 66  
Application for plugging approved August 22 19 66  
Plugging commenced August 22 19 66  
Plugging completed August 22 19 66  
Reason for abandonment of well or producing formation Dry Hole

If a producing well is abandoned, date of last production 19  
Was permission obtained from the Conservation Division or its agents before plugging was commenced? Yes

Name of Conservation Agent who supervised plugging of this well Don Truan  
Producing formation Depth to top Bottom Total Depth of Well Feet  
Show depth and thickness of all water, oil and gas formations.

OIL, GAS OR WATER RECORDS

CASING RECORD

FORMATION	CONTENT	FROM	TO	SIZE	PUT IN	PULLED OUT
Soil-clay-sand		0	976			
Anhydrite		976	986	8 5/8"	986	None

Describe in detail the manner in which the well was plugged, indicating where the mud fluid was placed and the method or methods used in introducing it into the hole. If cement or other plugs were used, state the character of same and depth placed, from feet to feet for each plug set.

Set plug, hulls and 25 sacks of cement through drill pipe at 980'.

Set plug and hulls and 20 sacks of cement through drill pipe at 400'.

Set plug and hulls and 10 sacks of cement at 40'.

RECORDED  
STATE CORPORATION COMMISSION

SEP 16 1966 REC'D

09-16-66

CONSERVATION DIVISION  
Wichita, Kansas

(If additional description is necessary, use BACK of this sheet)

Name of Plugging Contractor Burt Drilling Co.  
Address Great Bend, Kansas 67530

STATE OF KANSAS, COUNTY OF BARTON, ss.  
Burt Drilling Co. (employee of owner) or (owner or operator) of the above-described well, being first duly sworn on oath, says: That I have knowledge of the facts, statements, and matters herein contained and the log of the above-described well as filed and that the same are true and correct. So help me God.

(Signature) *Burt C. Burt*  
1823 Washington, Great Bend, Kansas  
(Address)

SUBSCRIBED AND SWORN to before me this 8th day of September, 1966

*Edmund J. Mauler*  
Notary Public.

My commission expires July 2, 1969



R. G. SMITH  
602 Rule Building  
Wichita, Kansas

Well: Ed Mater No. 1  
Commenced R. D.: 8/12/66  
Completed R. D.: 8/22/66  
Total Depth: 3500' D. F.  
Casing: 990' of 8 5/8 8rd thd.  
Surface Pipe

Sec.: 9-17-14W  
Barton County, Kansas  
Elevation:  
Initial Prod.: D. & A.  
Contractor: BURT DRILLING  
COMPANY

Strata	Depth
Post Rock	0- 80'
Shale & Shells	80- 226
Sand	226- 460
Shale & Shells	460- 505
Sand	505- 600
Shale & Redbed w/sand streaks	600- 870
Shale & Shells	870- 966
Anhydrite	966- 986
Anhydrite & Shells	986- 994
Shale & Shells	994-1665
Lime w/shale streaks	1665-1690
Lime & Shale	1690-2095
Lime w/shale streaks	2095-2215
Lime & Shale	2215-2330
Shale & Lime	2330-2725
Lime & Shale	2725-2952
Lime w/shale streaks	2952-3020
Lime	3020-3155
Heebner	3155-3159
Lime	3159-3186
Shale	3186-3218
Lime	3218-3460
Conglomerate	3460-3485
Arbuckle	3485-3500

RECEIVED  
STATE CORPORATION COMMISSION

SEP 16 1966


CONSERVATION DIVISION  
Wichita, Kansas

I hereby certify that the above is a true and correct log of said well as reflected by daily reports.

BURT DRILLING CO.



Signed and sworn in my presence this 29th day of August, 1966.



My Commission Expires: Oct. 15, 1967