

NOTICE OF INTENTION TO DRILL

(see rules on reverse side)

Starting Date 5/11/87
 month day year 1987

API Number 15—

151-21837-00 DP

OPERATOR: License # 4767
 Name Ritchie Exploration, Inc.
 Address 125 N. Market, Suite 1000
 City/State/Zip Wichita, KS 67202
 Contact Person Jeff Christian
 Phone 316/267-4375

E/2 SW SE 22 27 13 XX West
 660 Ft. from South Line of Section
 1650 Ft. from East Line of Section

(Note: Locate well on Section Plat on reverse side)

Nearest lease or unit boundary line 330 feet
 County Pratt

CONTRACTOR: License # 6033
 Name Murfin Drilling Co.
 City/State Wichita, KS 67202
 Well Drilled For 250 N Waterwell Class Type Equipment:
☒ Oil ☐ SWD ☐ Infield ☒ Mud Rotary
☐ Gas ☐ Inj ☐ Pool Ext. ☐ Air Rotary
☐ OWWO ☐ Expl ☒ Wildcat ☐ Cable

Lease Name S and M Farms Well # 1
 Ground surface elevation Est. 1912 feet MSL
 Domestic well within 330 feet: ☐ yes ☒ no
 Municipal well within one mile: ☐ yes ☒ no

Depth to bottom of fresh water 125
 Depth to bottom of usable water 200

Surface pipe by Alternate: 1 X 2
 Surface pipe planned to be set 225

Conductor pipe required
 Projected Total Depth 4550 feet

Formation Arbuckle

If OWWO: old well info as follows:

Operator

Well Name

Comp Date Old Total Depth

I certify that well will comply with K.S.A. 55-101, et seq., plus eventually plugging hole to KCC specifications.
 Date 5/08/87 Signature of Operator or Agent Jeff Christian Title Geologist

For KCC Use:

Conductor Pipe Required 225 feet; Minimum Surface Pipe Required 225 feet per Alt. 1

This Authorization Expires 11-11-87 Approved By 5-11-87

Move in 5-18-87 set 257

E/2 SW SE Sec. 22 Twp. 27 S, Rg. 13 ☒ West

PLUGGING PROPOSAL IF ABOVE IS D & A

This plugging proposal will be reviewed and approved or revised at the time the district office is called prior to setting surface casing (call 7 a.m. to 5 p.m. workdays).

1st plug @ <u>1020</u>	feet depth with <u>50</u>	sxs of <u>cement</u>
2nd plug @ <u>550</u>	feet depth with <u>40</u>	sxs of <u>cement</u>
3rd plug @ <u>40</u>	feet depth with <u>10</u>	sxs of <u>cement</u>
4th plug @	feet depth with	sxs of
5th plug @	feet depth with	sxs of

(2) Rathole with sxs (b) Mousehole with sxs

to surface minus 5' to surface minus 5'

PUSHER Rocky Ford
 TD FORMATION
 SURFACE PIPE 8 5/8 @ 257
 ANHYDRITE 736 ELEVATION
 STARTING TIME & DATE 50' - 4:15
 COMPLETION TIME & DATE 40' - 5:15
 1st PLUG @ 740 FT. W/ 50 SX
 2nd PLUG @ 270 FT. W/ 40 SX
 3rd PLUG @ 40-0 FT. W/ 10 SX
 4th PLUG @ FT. W/ SX
 RAT HOLE CIRCULATED W/ 10 SX
 MOUSE HOLE CIRCULATED W/ 10 SX
 WATER WELL PLUGGED W/ 10 SX
 CEMENT COMPANY Conrad
 TECHNICIAN

RECEIVED
 STATE CORPORATION COMMISSION

MAY 22 1987

CONSERVATION DIVISION
 Wichita, Kansas

CARD MUST BE TYPED

State of Kansas

CARD MUST BE SIGNED

NOTICE OF INTENTION TO DRILL

(see rules on reverse side)

Starting Date 5/11/87
 month day year 10 26

OPERATOR: License # 4767
 Name Ritchie Exploration, Inc.
 Address 125 N. Market, Suite 1000
 City/State/Zip Wichita, KS 67202
 Contact Person Jeff Christian
 Phone 316/267-4375

CONTRACTOR: License # 6033
 Name Murfin Drilling Co.
 City/State Wichita, KS

Well Drilled For:	Well Class:	Type Equipment:
☒ Oil	☐ SWD	☒ Infield
☐ Gas	☐ Inj	☐ Pool Ext.
☐ OWWO	☐ Expl	☒ Wildcat
		☐ Cable

If OWWO: old well info as follows:

Operator
 Well Name
 Comp Date Old Total Depth

I certify that well will comply with K.S.A. 55-101, et seq., plus eventually plugging hole to KCC specifications.

Date 5/08/87 Signature of Operator or Agent Jeff Christian

For KCC Use:

Conductor Pipe Required feet; Minimum Surface Pipe Required 225 feet per Alt. 1 20

This Authorization Expires 11-11-87 Approved By 5-11-87

API Number 15— 151-21,837-00-00
 E/2 SW SE 22 27 S, Rg. 13 XX West
 660 Ft. from South Line of Section
 1650 Ft. from East Line of Section

(Note: Locate well on Section Plat on reverse side)

Nearest lease or unit boundary line 330 feet
 County Pratt
 Lease Name S. and M. Farms. Well # 1
 Ground surface elevation est. 1912 feet MSL
 Domestic well within 330 feet: yes XX no
 Municipal well within one mile: yes XX no
 Depth to bottom of fresh water 125
 Depth to bottom of usable water 200
 Surface pipe by Alternate: 1 X 2
 Surface pipe planned to be set 225
 Conductor pipe required
 Projected Total Depth 4550 feet
 Formation Arbuckle


Geologist Title

Must be filed with the K.C.C. five (5) days prior to commencing well
This card void if drilling not started within six (6) months of date received by K.C.C.

Important procedures to follow:

1. Notify District office before setting surface casing.
 2. Set surface casing by circulating cement to the top.
 3. File completion forms ACO-1 with K.C.C. within 90 days of well completion, following instructions on ACO-1, side 1, and including copies of wireline logs.
 4. Notify District office 48 hours prior to old well workover or re-entry.
 5. Prior to filing Intent, prepare a proposed plugging plan in case well is D & A, then obtain approval of plan when calling district office prior to setting surface pipe.
 6. Submit plugging report (CP-4) to K.C.C. after plugging is completed.
 7. Obtain an approved injection docket number before disposing of salt water.
- Notify K.C.C. within 10 days when injection commences or terminates.

A Regular Section of Land
1 Mile = 5,280 Ft.

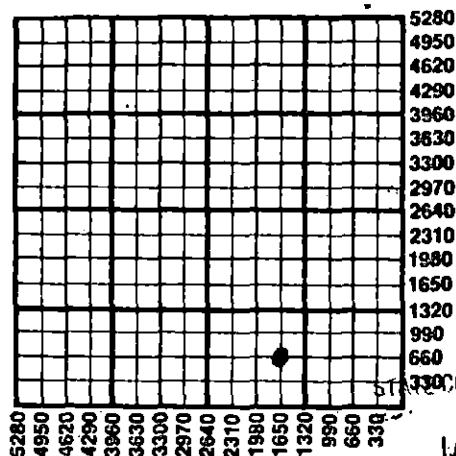

RECEIVED
STATE CORPORATION COMMISSION

MAY 11 1987

CONSERVATION DIVISION
Wichita, Kansas

If an alternate 2 completion, cement in the production pipe from below any usable water to surface within 120 days of spud date.

State Corporation Commission of Kansas
Conservation Division
200 Colorado Derby Building
Wichita, Kansas 67202
(316) 263-3238