


STATE OF KANSAS
STATE CORPORATION COMMISSION

WELL PLUGGING RECORD

Give All Information Completely
Make Required Affidavit
Mail or Deliver Report to:
Conservation Division
State Corporation Commission
800 Bittling Building
Wichita, Kansas

NORTH

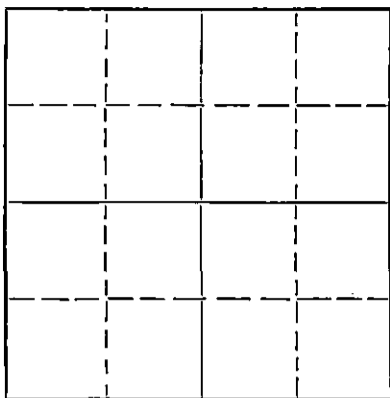

Locate well correctly on above
Section Plat

Pratt County, Sec. 17 Twp. 27 Rge. 13 (E) W (W)
Location as "NE/CNW $\frac{1}{4}$ SW $\frac{1}{4}$ " or footage from lines SW SW SW
Lease Owner B & R Drilling, Inc.
Lease Name City of Pratt Well No. 1
Office Address Russell, Kansas
Character of Well (completed as Oil, Gas or Dry Hole) Dry Hole
Date well completed May 23, 1952 19
Application for plugging filed May 22, 1952 19
Application for plugging approved May 22, 1952 19
Plugging commenced May 23, 1952 19
Plugging completed May 23, 1952 19
Reason for abandonment of well or producing formation Dry Hole

If a producing well is abandoned, date of last production 19
Was permission obtained from the Conservation Division or its agents before plugging was commenced? Yes

Name of Conservation Agent who supervised plugging of this well M. A. Rives
Producing formation Depth to top Bottom Total Depth of Well 4600 Feet
Show depth and thickness of all water, oil and gas formations.

OIL, GAS OR WATER RECORDS

CASING RECORD

Formation	Content	From	To	Size	Put In	Pulled Out
				8 5/8"	356	None

Describe in detail the manner in which the well was plugged, indicating where the mud fluid was placed and the method or methods used in introducing it into the hole. If cement or other plugs were used, state the character of same and depth placed, from feet to feet for each plug set.

PLUGGING RECORD

Layed down drill pipe. Filed hole to 301' with heavy mud. Wooden plug and 20 sacks cement through drill pipe, filled hole to 37' with heavy mud. Wooden plug and 10 sacks cement.

RECEIVED
STATE CORPORATION COMMISSION
JUN 2 1952
CONSERVATION DIVISION
Wichita, Kansas

Name of Plugging Contractor
Address

STATE OF KANSAS, COUNTY OF RUSSELL, ss.
W. A. Michaelis, Jr. (employee of owner) or (owner or operator) of the above-described well,

being first duly sworn on oath, says: That I have knowledge of the facts, statements, and matters herein contained and the log of the above-described well as filed and that the same are true and correct. So help me God.


(Signature) W. A. Michaelis, Jr.
Russell, Kansas
(Address)

SUBSCRIBED AND SWORN to before me this 28th day of May, 1952

Notary Public

My commission expires 6-17-54

23-8390-s 6-51-20M

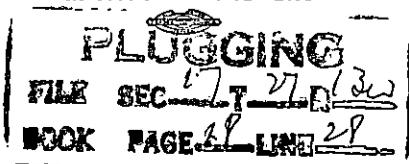

B & R Drilling, Inc.
City of Pratt #1

SW SW SW Sec. 17-27-13
Pratt County, Kansas.

Total Depth: 4600'
Comm. 4/16/52
Comp. 5/23/52

Casing

8 5/8" Set @ 356'

Cement

250 sacks Bulk

Formation	Depth
Clay-shale	45
Shale	85
Sand	100
Sand-shale	220
Shale	240
Red Bed	849
Anhydrite	880
Shale	915
Shale-red bed	1075
Shale-shells	1220
Shale-salt	1580
Shale-shells	1870
Lime	1925
Lime-shale	2030
Lime	2275
Lime-shale	3199
Shale	3255
Lime	3395
Lime-shale	3470
Lime	3613
Lime-shale	3675
Lime	3716
Lime-shale	3845
Lime	4019
Lime-shale	4054
Lime	4233
Shale-lime	4321
Shale	4350
Shale-lime-chert.	4400
Chert	4409
Chert-hard sand	4445
Sand	4511
Sand-shale	4531
Arbuckle lime	4562
Lime	4600'

STATE OF KANSAS)
) ss
RUSSELL COUNTY)

RECEIVED
CORPORATION COMMISSION
JUN 2 - 1952
CONSERVATION DIVISION
Pratt, Kansas

I hereby certify that the above information is true and correct to the best of my knowledge.

Car. Belf

Subscribed and sworn to before me this 28th day of May, 1952.

PLUGGING
FILE SEC-17-27-13
BOOK PAGE-18 LINE 28

Christy Howard

Notary Public

My commission expires: 6-17-54.