

STATE OF KANSAS  
STATE CORPORATION COMMISSION

WELL PLUGGING RECORD

Give All Information Completely  
Make Required Affidavit  
Mail or Deliver Report to:  
Conservation Division  
State Corporation Commission  
800 Bittling Building  
Wichita, Kansas

Pratt

County. Sec. 19 Twp. 27S Rge. 13W (XXX) (W)

Location as "NE/CNW%SW%" or footage from lines SE NE NE

Lease Owner Sohio Petroleum Company

Lease Name Lampe Well No. 1

Office Address P. O. Box 673, Russell, Kansas

Character of Well (completed as Oil, Gas or Dry Hole) Dry hole

Date well completed 3-18 19 54

Application for plugging filed 3-22 19 54

Application for plugging approved 3-22 19 54


Plugging commenced 3-18 19 54

Plugging completed 3-18 19 54

Reason for abandonment of well or producing formation Dry hole

If a producing well is abandoned, date of last production 19

Was permission obtained from the Conservation Division or its agents before plugging was commenced? Yes

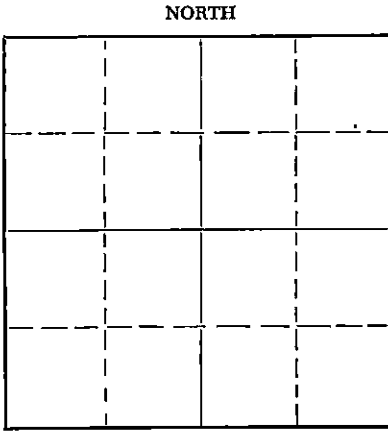

Locate well correctly on above Section Plat

Name of Conservation Agent who supervised plugging of this well

Producing formation Depth to top Bottom Total Depth of Well 4598 Feet

Show depth and thickness of all water, oil and gas formations.

OIL, GAS OR WATER RECORDS

CASING RECORD

FORMATION	CONTENT	FROM	TO	SIZE	PUT IN	PULLED OUT
				8-5/8"	372'	None

Describe in detail the manner in which the well was plugged, indicating where the mud fluid was placed and the method or methods used in introducing it into the hole. If cement or other plugs were used, state the character of same and depth placed, from feet to feet for each plug set.

Hole was mudded to 300' and bridged at that point.  
20 sax cement were dumped in open hole.  
Hole was mudded to 40' and after bridging at that point, the well was plugged to bottom of cellar with 10 sacks common cement.  
Plugging and abandoning operations completed as of Midnight 3-18-54

RECORDED  
STATE CORP. COMMISSION

3-25-54

CONSERVATION DIVISION  
Wichita, Kansas

(If additional description is necessary, use BACK of this sheet)

Name of Plugging Contractor  
Address

STATE OF KANSAS, COUNTY OF RUSSELL, ss.  
D. W. Smith (employee of owner) or authorized operator of the above-described

well, being first duly sworn on oath, says: That I have knowledge of the facts, statements, and matters herein contained and the log of the above-described well as filed and that the same are true and correct. So help me God.

(Signature) D. W. Smith

(Address)

SUBSCRIBED AND SWORN TO before me this 24th day of March, 1954

Russell B. Miller  
Notary Public.

My commission expires July 2, 1957

PLUGGING  
FILE REC 19 T 27 R 13W  
BOOK PAGE 21 LINE 24

Trans Era Petroleum, Inc. *Ohio*  
Lampe #1

Pratt County, Kansas  
SE NE NE 19-27-31

Total Depth: 4598'  
Comm. 2/26/54  
Comp. 3/18/54

Casing

8 5/8" Set @ 372'

Cement

250 sacks Portland

Formation	Depth
Clay	60
Sand-gravel	170
Red bed	850
Anhydrite	890
Red bed-shale	1260
Shale	1710
Lime-shale	1775
Salt	1805
Shale-lime	1915
Lime	2165
Shale-lime	2260
Lime	2535
Lime-shale	3436
Lime	4379
Viola	4419
Lime	4542
Arbuckle	4598'

STATE OF KANSAS }  
RUSSELL COUNTY } ss

I hereby certify that the above information is true and correct to the best of my knowledge.

*Cora Betz*  
-----

Subscribed and sworn to before me this 23rd day of March, 1954.

*Margie Cooper*  
-----  
Notary Public

My commission expires: 1-30-57.

PLUGGING  
FILE SEC 19 T 27 R 13W  
BOOK PAGE 21 LINE 24

RECEIVED  
STATE CORPORATION COMMISSION  
MAR 25 1954  
CONSERVATION DIVISION  
Wichita, Kansas