


STATE OF KANSAS  
STATE CORPORATION COMMISSION

WELL PLUGGING RECORD

Give All Information Completely  
Make Required Affidavit  
Mail or Deliver Report to:  
Conservation Division  
State Corporation Commission  
800 Bitting Building  
Wichita, Kansas

Pratt County. Sec. 20 Twp. 27 Rge. (E) 13 (W)  
Location as "NE/CNW&SW¼" or footage from lines NE NE SE  
Lease Owner Musgrove Petroleum Corporation  
Lease Name MOON Well No. 1  
Office Address 518 Petroleum Building, Wichita, Kansas.  
Character of Well (completed as Oil, Gas or Dry Hole) Dry hole  
Date well completed December 20, 19 53  
Application for plugging filed December 20, (verbally) 19 53  
Application for plugging approved December 20, " 19 53  
Plugging commenced December 20, 19 53  
Plugging completed December 20, 19 53  
Reason for abandonment of well or producing formation Dry hole

NORTH

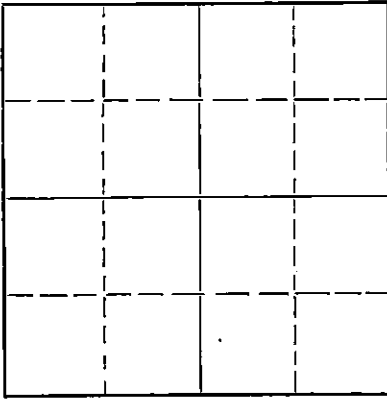

Locate well correctly on above  
Section Plat

If a producing well is abandoned, date of last production \_\_\_\_\_ 19\_\_\_\_  
Was permission obtained from the Conservation Division or its agents before plugging was commenced? Yes - verbally

Name of Conservation Agent who supervised plugging of this well \_\_\_\_\_  
Producing formation \_\_\_\_\_ Depth to top \_\_\_\_\_ Bottom \_\_\_\_\_ Total Depth of Well 4597 Feet  
Show depth and thickness of all water, oil and gas formations.

OIL, GAS OR WATER RECORDS

CASING RECORD

FORMATION	CONTENT	FROM	TO	SIZE	PUT IN	PULLED OUT
				8-5/8"	322'	

Describe in detail the manner in which the well was plugged, indicating where the mud fluid was placed and the method or methods used in introducing it into the hole. If cement or other plugs were used, state the character of same and depth placed, from \_\_\_\_\_ feet to \_\_\_\_\_ feet for each plug set.

Set first plug at 300' with 20 sacks cement.  
Set second plug at 40' with 10 sacks cement.

(If additional description is necessary, use BACK of this sheet)

Name of Plugging Contractor Musgrove Petroleum Corporation,  
Address 518 Petroleum Building, Wichita, Kansas.

STATE OF Kansas COUNTY OF Sedgwick  
I, GORDON L. KOELLING (employee of owner) or (owner or operator) of the above-described well, being first duly sworn on oath, says: That I have knowledge of the facts, statements, and matters herein contained and the log of the above-described well as filed and that the same are true and correct. So help me God.

(Signature) Gordon L. Koelling  
518 Petroleum Building, Wichita, Kansas.  
(Address)

SUBSCRIBED AND SWORN to before me this 28th day of December 19 53

My commission expires September 24, 1956.

[Signature]  
Notary Public.

**PLUGGING**  
FILE SEC 20 T 27 R 13W  
BOOK PAGE 2 LINE 45

12-30-53

CONTRACTOR'S WELL LOG

COMPANY:	Musgrove Petroleum Corporation
CONTRACTOR:	Musgrove Petroleum Corporation
FARM:	Moon #1 NE NE SE, Sec. 20-27-13 Pratt County, Kansas.
COMMENCED:	December 4, 1953.
COMPLETED:	December 20, 1953

0	65	Clay
65	205	Sand
205	490	Red Bed
490	790	Red bed, sand, chalk, rock
790	820	Anhydrite
820	1150	Bl. shale, red bed, shale
1150	1455	Sandy shale & shells
1455	1870	Shale & shells
1870	1975	Fort Riley, Lime & shale
1975	4274	Lime & shale
4274	4405	Lime, shale & chert
4405	4475	Lime, chert & chat
4475	4505	Lime & chert
4505	4597	Lime, chert & shale
	4597	Rotary Total Depth

Set 8-5/8" surface pipe at 322' with 225 sacks cement and 3 sacks calcium chloride.

Dry and Abandoned.

STATE OF KANSAS )  
COUNTY OF SEDGWICK ) SS

I, GORDON L. KOELLING, do hereby certify that the above and foregoing is a true and correct copy of the log of the Moon #1, NE NE SE, Section 20-27-13, Pratt County, Kansas, as reflected by the files of the Musgrove Petroleum Corporation.

MUSGROVE PETROLEUM CORPORATION

*Gordon L. Koelling*  
Secretary-Treasurer

Subscribed and sworn to before me, a Notary Public, in and for Sedgwick County, Kansas, this 28th day of December 1953.

*William L. Stinson*  
Notary Public

My commission expires September 24, 1956.

**PLUGGING**  
FILE SEC 20 T 27 R 13W  
BOOK PAGE 2 LINE 45