

WELL PLUGGING RECORD

Give All Information Completely  
Make Required Affidavit  
Mail or Deliver Report to:  
Conservation Division  
State Corporation Commission  
211 No. Broadway  
Wichita, Kansas

Pratt County. Sec. 22 Twp. 27 S Rge. 13 (E) 13 (W)

Location as "NE/CNW%SW%" or footage from lines. NE/4 NW/4 NE/4

Lease Owner Messman-Rinehart Oil Company

Lease Name Udry Well No. 1

Office Address 518 Petroleum Building, Wichita, Kansas

Character of Well (completed as Oil, Gas or Dry Hole) Dry Hole

Date well completed October 17 19 62

Application for plugging filed October 17 19 62

Application for plugging approved October 17 19 62


Plugging commenced October 17 19 62

Plugging completed October 17 19 62

Reason for abandonment of well or producing formation Dry

If a producing well is abandoned, date of last production \_\_\_\_\_ 19 \_\_\_\_\_

Was permission obtained from the Conservation Division or its agents before plugging was commenced? yes

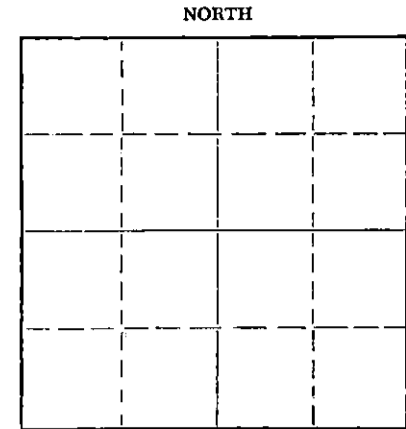

Locate well correctly on above Section Plat

Name of Conservation Agent who supervised plugging of this well W. L. Lackamp, R.R. #1, Stafford, Kansas

Producing formation \_\_\_\_\_ Depth to top \_\_\_\_\_ Bottom \_\_\_\_\_ Total Depth of Well 4522 Feet

Show depth and thickness of all water, oil and gas formations.

OIL, GAS OR WATER RECORDS

CASING RECORD

FORMATION	CONTENT	FROM	TO	SIZE	PUT IN	PULLED OUT
				<u>10-3/4"</u>	<u>261'</u>	<u>none</u>

Describe in detail the manner in which the well was plugged, indicating where the mud fluid was placed and the method or methods used in introducing it into the hole. If cement or other plugs were used, state the character of same and depth placed, from \_\_\_\_\_ feet to \_\_\_\_\_ feet for each plug set.

Set plug at 240 ft. with 30 sx. cement and 1/4 sk. hulls. Set plug at 30 ft. with 10 sx. cement and 1/4 sk. hulls.

**RECEIVED**  
STATE CORPORATION COMMISSION

NOV 9 1962 11-2-62

CONSERVATION DIVISION  
Wichita, Kansas

(If additional description is necessary, use BACK of this sheet)

Name of Plugging Contractor Messman-Rinehart Oil Company  
Address 518 Petroleum Building, Wichita, Kansas

STATE OF Kansas, COUNTY OF Sedgwick, ss.

J. A. Gilliland (employee of owner) of the above-described well, being first duly sworn on oath, says: That I have knowledge of the facts, statements, and matters herein contained and the log of the above-described well as filed and that the same are true and correct. So help me God.

(Signature) \_\_\_\_\_

518 Petroleum Building, Wichita, Kansas

(Address)

SUBSCRIBED AND SWORN TO before me this 1st day of November, 19 62

My commission expires December 1, 1964

Barbara J. Teat  
Notary Public.



NO. 1 UDRY

Well Record:

Location: NE/4 NW/4 NE/4  
 Section 22-27S-13W  
 Pratt, Kansas

Operator: Messman-Rinehart Oil Company  
 518 Petroleum Building  
 Wichita, Kansas

Contractor: Messman-Rinehart Oil Company  
 518 Petroleum Building  
 Wichita, Kansas

Casing Record: 10-3/4" @ 261' w/200 sx. cem.

Commenced: September 27, 1962  
 Completed: October 17, 1962  
 Elevation: 1933' K/B  
 Production: D & A

\*\*\* LOG \*\*\*

Surface Clay 35  
 Sand 125  
 Red Bed & Shells 261  
 Shale & Shells 755  
 Anhydrite 770  
 Shale 785  
 Shale & Red Bed 1400  
 Red Bed & Shale 1635  
 Shale & Lime Shells 1875  
 Shale & Lime Streaks 1975  
 Lime 2371  
 Lime & Shale 3370  
 Lime 3470  
 Lime & Shale 3520  
 Lime 3650  
 Shale & Sand 3750  
 Lime 4170  
 Lime & Chert 4225  
 Lime 4270  
 Lime & Chert 4360  
 Cherty Lime 4377  
 Sandy Lime with Chert 4392  
 Core 4452  
 Shale 4522 R.T.D.

Sample Tops:  
 3629' - Haebner (-1696)  
 3795' - Brown Lime (-1862)  
 3817' - Lansing-Kansas City (-1884)  
 4238' - Mississippian (-2305)  
 4289' - Kinderhook (-2356)  
 4315' - Viola (-2382)  
 4377' - Simpson Shale (-2444)  
 4381' - Simpson Sand (-2448)  
 4502' - Arbuckle (-2569)

The undersigned, MESSMAN-RINEHART OIL COMPANY, hereby certifies that the above log is a true and correct log of the formation encountered in drilling the above well as reflected by the Daily Drilling Reports.

MESSMAN-RINEHART OIL COMPANY

By: \_\_\_\_\_

*J. A. Giffland*  
 J. A. Giffland

Subscribed and sworn to before me  
 this 31st day of October, 1962

*Barbara J. Scott*  
 Barbara J. Scott, Notary Public

My Commission Expires: December 1, 1964

RECEIVED  
 CONSERVATION COMMISSION  
 NOV 1 1962  
 CONSERVATION DIVISION  
 Wichita, Kansas