

STATE OF KANSAS  
STATE CORPORATION COMMISSION


WELL PLUGGING RECORD

Give All Information Completely  
Make Required Affidavit  
Mail or Deliver Report to:  
Conservation Division  
State Corporation Commission  
800 Bitting Building  
Wichita, Kansas

Pratt County, Sec. 11 Twp 27S Rge. 14 (X) (W)

Location as "NE/CNW/SW" or footage from lines SW SE NW  
Lease Owner Lario Oil & Gas Company  
Lease Name Alvin Ewbank Well No. 1  
Office Address 301 S. Market, Wichita, Kansas  
Character of Well (completed as Oil, Gas or Dry Hole) Dry Hole  
Date well completed January 13, 19 55  
Application for plugging filed January 13, 19 55  
Application for plugging approved January 13, 19 55  
Plugging commenced January 13, 19 55  
Plugging completed January 13, 19 55  
Reason for abandonment of well or producing formation Dry

NORTH

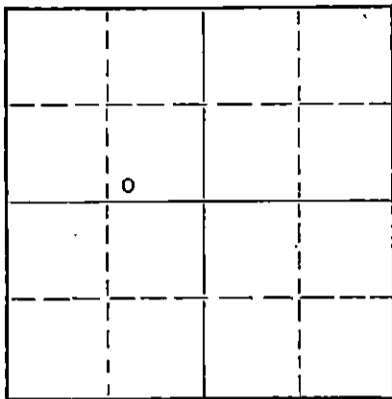

Locate well correctly on above Section Plat

If a producing well is abandoned, date of last production 19  
Was permission obtained from the Conservation Division or its agents before plugging was commenced? yes

Name of Conservation Agent who supervised plugging of this well M. A. Rives  
Producing formation Depth to top Bottom Total Depth of Well 4641' Feet  
Show depth and thickness of all water, oil and gas formations.

OIL, GAS OR WATER RECORDS

CASING RECORD

FORMATION	CONTENT	FROM	TO	SIZE	PUT IN	PULLED OUT
		0	347	13 3/8"	347'	0

Describe in detail the manner in which the well was plugged, indicating where the mud fluid was placed and the method or methods used in introducing it into the hole. If cement or other plugs were used, state the character of same and depth placed, from feet to feet for each plug set.

From 4641' back to 300' with heavy rotary mud. One plug set at 300' with 30 sacks cement. From 300' back to 20' with heavy rotary mud with second plug set at 20' with 20 sacks cement.

01-18-53

(If additional description is necessary, use BACK of this sheet)

Name of Plugging Contractor Buick Drilling Inc.  
Address P. O. Box 331, St. John, Kansas

STATE OF Kansas, COUNTY OF Stafford, ss.  
H. R. Buick (employee of owner) or (owner or operator) of the above-described well, being first duly sworn on oath, says: That I have knowledge of the facts, statements, and matters herein contained and the log of the above-described well as filed and that the same are true and correct. So help me God.

(Signature) *H. R. Buick*  
P. O. Box 331, St. John, Kansas (Address)

SUBSCRIBED AND SWORN to before me this 15th day of January, 19 55

*Roberta Ahgren*  
Notary Public.

My commission expires December 26, 1955.

PLUGGING  
FILED SEC 11 T 27 R 14 W  
BOOK PAGE 91 LINE 22

DRILLERS LOG

#1 Alvin Ewbank  
 Commenced R.D.: 12-14-54  
 Completed R.D.: 1-13-55  
 Total Depth: 4641'  
 Casing Record: 247', 13 3/8"

SW SE NW, Sec. 11-27S-14W  
 Pratt County, Kansas  
 Elevation: 1988 D.F.  
 Initial Prod.: None  
 Contractor: Buick Drilling Inc.

STRATA	DEPTH
Sandy soil	0 - 70
Sand	70 - 145
Shale	145 - 160
Sand and Gravel	160 - 240
Red Bed	240 - 530
Sand	530 - 600
Red Bed	600 - 890
Anhydrite	890 - 915
Shale and shells	915 - 1360
Salt and shale	1360 - 1510
Shale and shells	1510 - 1930
Lime and shale	1930 - 2065
Lime	2065 - 2215
Lime and shale	2215 - 2730
Shale	2730 - 2802
Shale and lime	2802 - 3540
Lime	3540 - 3590
Lime and shale	3590 - 3890
Lime	3890 - 3928
Lime and shale	3928 - 3960
Lime	3960 - 4021
Lime and shale	4021 - 4045
Lime	4045 - 4120
Lime and shale	4120 - 4144
Lime	4144 - 4170
Lime and shale	4170 - 4240
Lime	4240 - 4265
Lime and shale	4265 - 4388
Chert	4388 - 4390
Chert and sand	4390 - 4412
Chert	4412 - 4416
Chert, lime and shale	4416 - 4465
Chert	4465 - 4482
Cherty lime and shale	4482 - 4503
Chert, lime and shale	4503 - 4521
Shale and lime	4521 - 4633
Lime	4633 - 4641 T.D.

I hereby certify the above a true and correct drilling log as reflected by the drilling reports of the Buick Drilling Inc.

BUICK DRILLING INC.

H. R. Buick  
 H. R. Buick, President

Signed and sworn to in my presence this 15th day of January, 1955, by H. R. Buick, President of the Buick Drilling Inc.

Roberta Shogren  
 Notary Public

My commission expires December 26, 1955.

PLUGGING  
 FILED SEC 11 T 27 R 14W  
 BOOK PAGE 91 LINE 22