

STATE OF KANSAS
STATE CORPORATION COMMISSION

WELL PLUGGING RECORD

Give All Information Completely
Make Required Affidavit
Mail or Deliver Report to
Conservation Division
State Corporation Comm.
245 North Water
Wichita, KS 67202

Pratt County, Sec. 34 Twp. 27S Rge. 14W E/W
Location as "NE/CNW $\frac{1}{4}$ SW $\frac{1}{4}$ " or footage from lines _____
C NW NE


Lease Owner Texas Energies, Inc.
Lease Name McBride Well No. 1
Office Address 300 Bank of the SW, Bldg. Amarillo, Texas 79109
Character of Well (Completed as Oil, Gas or Dry Hole) _____

Date Well completed _____ 19____
Application for plugging filed 5-8 1979
Application for plugging approved 5-10 1979
Plugging commenced 5-17 1979
Plugging completed 5-19 1979
Reason for abandonment of well or producing formation _____

If a producing well is abandoned, date of last production _____ 19____

Was permission obtained from the Conservation Division or its agents before plugging was commenced? Yes

Name of Conservation Agent who supervised plugging of this well Bill Owens
Producing formation _____ Depth to top _____ Bottom _____ Total Depth of Well 4634
Show depth and thickness of all water, oil and gas formations.

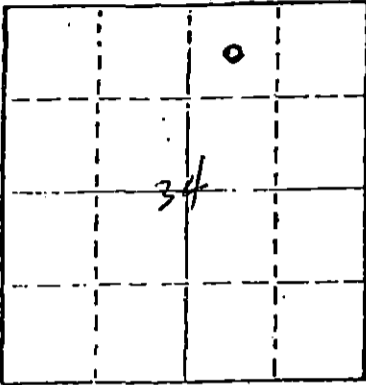

Locate well correctly on above Section Plat

OIL, GAS OR WATER RECORDS

CASING RECORD

FORMATION	CONTENT	FROM	TO	SIZE	PUT IN	PULLED OUT
				8 5/8	437	none
				5 1/2	4200	2608

Describe in detail the manner in which the well was plugged, indicating where the mud fluid was placed and the method or methods used in introducing it into the hold. If cement or other plugs were used, state the character of same and depth placed, _____ feet to _____ feet for each plug set.

- Pump 50 sks. of cement @ 3126
- Pump 40 sks. of cement @ 400 to 310
- Put 12 sks. of cement @ 40 to 4

RECEIVED
STATE CORPORATION COMMISSION

JUN 14 1979 06-14-79

CONSERVATION DIVISION
Wichita, Kansas

(If additional description is necessary, use BACK of this sheet)

Name of Plugging Contractor Sargent's Casing Pulling Ser. Box 506 Liberal, Kansas 67901

STATE OF Kansas COUNTY OF Pratt, ss.
Lloyd E. Geoffroy, Jr. (employee of owner) or (owner or operator)


of the above-described well, being first duly sworn on oath, says: That I have knowledge of the facts, statements, and matters herein contained and the log of the above-described well as filed and that the same are true and correct. So help me God.

(Signature) [Signature]
(Address) _____

SUBSCRIBED AND SWORN TO before me this 13 day of June, 1979

My commission expires April 23, 1983

Darlene Butts
Darlene Butts Notary Public.

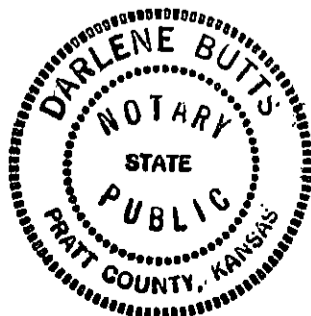

GABBERT-JONES, INC.
 WICHITA, KANSAS
 DRILLERS' WELL LOG (CORRECTED from 9-10-76)

McBride #1
 NE/4 Sec 34-27S-14W
 Pratt County Kansas

Commenced: 8-27-76

Completed: 9-8-76

RECEIVED
 STATE CORPORATION COMMISSION

MAY 10 1979

CONSERVATION DIVISION
 Wichita, Kansas

OPERATOR: TEXAS ENERGIES, INC.

Depth		Formation	Remarks
From	To		
0	60	Clay	Ran 11 jts of 8 5/8" csg set @ 437' Cemented w/ 350 sks Common 3% CC PD @ 9:30 p.m. 8-27-76
60	90	Sand	
90	865	Shale-Shells	
865	890	Anhy	
890	1865	Shale-Shells	
1865	2030	Shale-Lime	
2030	2450	Lime-Shale	
2450	2635	Shale-Lime	
2635	3035	Lime-Shale	
3035	3885	Shale-Lime	
3885	4630	Lime	

Ran 124 jts of 14 & 15# 5 1/2" csg set @ 4200' Cemented w/15 bbl Salt Flush - 125 mks 50/50 Posmix 18% Salt 2% Gel PD @ 1:40 a.m. 9-8-76

4630 TD

STATE OF KANSAS)
) SS
 COUNTY OF SEDGWICK)

I, the undersigned, being duly sworn on oath, state that the above Drillers Log is true and correct to the best of my knowledge and belief and according to the records of this office.

GABBERT-JONES, INC.

James S. Sutton II
 JAMES S. SUTTON II

Subscribed and sworn to before me this 13 day of September, 1976.

Elizabeth J. Edwards
 ELIZABETH J. EDWARDS-NOTARY PUBLIC

My Commission expires February 6, 1976.