

STATE OF KANSAS
STATE CORPORATION COMMISSION


WELL PLUGGING RECORD

Give All Information Completely
Make Required Affidavit
Mail or Deliver Report to:
Conservation Division
State Corporation Commission
800 Bitting Building
Wichita, Kansas

OR
FORMATION PLUGGING RECORD

Strike out upper line
when reporting plug-
ging off formations.

NORTH

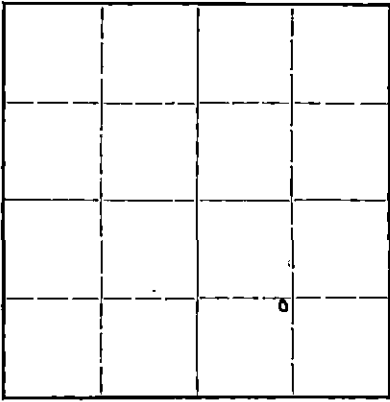

Locate well correctly on above
Section Plat

Pratt County. Sec. 30 Twp. 27 Rge. 14 (E) (W)
Location as "NE 1/4 NW 1/4 SW 1/4" or footage from lines Center NE/Corner SW SE
Lease Owner. Lion Chemical Corporation
Lease Name. Verning Well No. #1
Office Address. P. O. Box 552, Pratt, Kansas
Character of Well (completed as Oil, Gas or Dry Hole). Dry hole
Date well completed. 12-14 19.46
Application for plugging filed. 12-14 19.46
Application for plugging approved. 12-14 19.46
Plugging commenced. 12-14 19.46
Plugging completed. 12-15 19.46
Reason for abandonment of well or producing formation. Dry hole

If a producing well is abandoned, date of last production. None 19.
Was permission obtained from the Conservation Division or its agents before plugging was com-
menced? Yes

Name of Conservation Agent who supervised plugging of this well. W. H. Kerr
Producing formation. None Depth to top. Bottom. Total Depth of Well. 4785 Feet
Show depth and thickness of all water, oil and gas formations.

OIL, GAS OR WATER RECORDS


CASING RECORD

Formation	Content	From	To	Size	Put In	Pulled Out
				8-5/8"	790'	None

Describe in detail the manner in which the well was plugged, indicating where the mud fluid was placed and the method or methods used in introducing it into the hold. If cement or other plugs were used, state the character of same and depth placed, from _____ feet to _____ feet for each plug set.

Heavy mud to 300' and set bridging plug with 15 sacks of cement
Heavy mud to 30' and set bridging plug with 10 sack of cement

PLUGGING
FILE 30 27-146
BOOK 87-13

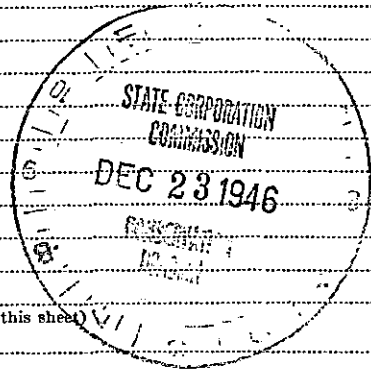

(If additional description is necessary, use BACK of this sheet)

Correspondence regarding this well should be addressed to. Vernon Hayes
Address. P. O. Box 552
Pratt, Kansas

STATE OF Kansas, COUNTY OF Pratt, ss.
Vernon Hayes (employee of owner) or (owner or operator) of the above-described well,

being first duly sworn on oath, says: That I have knowledge of the facts, statements, and matters herein contained and the log of the above-described well as filed and that the same are true and correct. So help me God.

(Signature) Vernon Hayes

P. O. Box 552, Pratt, Kansas (Address)

SUBSCRIBED AND SWORN to before me this 21st day of December, 19.46

Patricia Hannigan Reg of Deeds
Notary Public

My commission expires with office

Lion Chemical Corporation
El Dorado, Arkansas


Verning Well No. 1

Center NE SW SE
Sec. 30-27S-14W
Pratt County, Kansas

Contractor: The R. W. Rine Drilling Company
Started: 11-26-46 Finished: 12-14-46

LOG

Sand	0- 40	
Sand and red bed	40- 310	
Red bed and shale	310- 680	
Red bed and shells	680- 790	8 5/8" casing cemented @ 790'
Red bed and shells	790- 830	
Sand	830- 880	
Red bed and shale	880-1020	
Salt	1020-1360	
Shale and shells	1360-1995	
Sand and lime	1995-2115	
Lime	2115-2470	
Shale	2470-2575	
Lime and shale	2575-2945	
Shale	2945-3020	
Lime and shale	3020-3250	
Lime	3250-3310	
Shale	3310-3340	
Lime and shale	3340-3550	
Shale	3550-3625	
Lime	3625-3660	
Sand	3660-3670	
Sand and lime	3670-3705	
Lime	3705-3970	
Shale	3970-3987	
Lime	3987-4300	
Lime and shale	4300-4350	
Lime	4350-4380	
Shale and chert	4380-4410	
Lime	4410-4435	
Shale	4435-4455	
Lime and chert	4455-4473	
Shale and chert	4473-4497	
Lime	4497-4537	
Shale and lime	4537-4620	
Lime	4620-4647	
Sand	4647-4673	
Shale	4673-4720	
Shale and lime	4720-4783	
Lime	4783-4785	

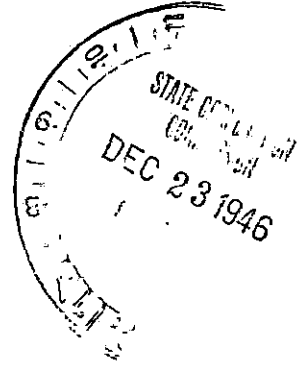

30 27 14W
87 13

TOTAL DEPTH: 4785'
Dry and abandoned

State of Kansas)
County of Barton)^{ss}

I, Clyde W. Goddard, do hereby certify that the above is a true and complete log of the Verning Well No. 1 located in Sec. 30-27S-14W of Pratt County, Kansas.

Clyde W. Goddard
Secretary

Sworn to and subscribed before me this 19th day of December, 1946.

Louella Hancy
Notary Public