

STATE OF KANSAS  
STATE CORPORATION COMMISSION

WELL PLUGGING RECORD

Give All Information Completely  
Make Required Affidavit  
Mail or Deliver Report to:  
Conservation Division  
State Corporation Commission  
211 No. Broadway  
Wichita, Kansas

Pratt

County, Sec. 29 Twp. 27S Rge. 14 (W)

Location as "NE/CNW/SW" or footage from lines NW NW SE

Lease Owner Parker Petroleum Company, Inc.

Lease Name Ivan Adams Well No. 1

Office Address Box 791 - Ponca City, Oklahoma

Character of Well (completed as Oil, Gas or Dry Hole) Dry Hole

Date well completed 9-3 19 56

Application for plugging filed 9-3 19 56

Application for plugging approved 9-3 19 56


Plugging commenced 9-3 19 56

Plugging completed 9-3 19 56

Reason for abandonment of well or producing formation Dry Hole

If a producing well is abandoned, date of last production 19

Was permission obtained from the Conservation Division or its agents before plugging was commenced? Yes

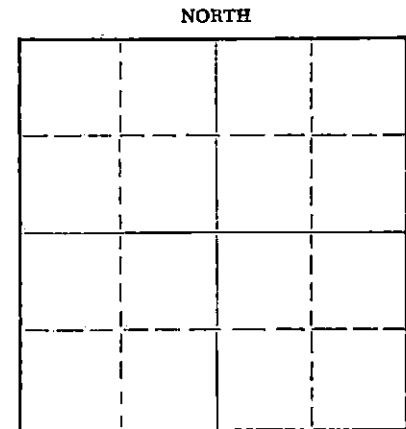

Locate well correctly on above Section Plat

Name of Conservation Agent who supervised plugging of this well M. A. Rives

Producing formation Depth to top Bottom Total Depth of Well 4605 Feet

Show depth and thickness of all water, oil and gas formations.

OIL, GAS OR WATER RECORDS

CASING RECORD

FORMATION	CONTENT	FROM	TO	SIZE	PUT IN	PULLED OUT
Heebner	No Show	3720		10 3/4	353	
Toronto		3756				
Brown Lime		3924				
Lansing		3956				
Cherty Conglomerate		4366				
Viola		4451				
Simpson		4485				
Arbuckle		4508				

Describe in detail the manner in which the well was plugged, indicating where the mud fluid was placed and the method or methods used in introducing it into the hole. If cement or other plugs were used, state the character of same and depth placed, from feet to feet for each plug set.

Hole filled with heavy rotary mud from 4605 to 300'. Halliburton plug set with 20 sacks cement. Hole filled with mud and hulls to 30'. Plug set and cemented with 10 sacks of cement to cap the plug.

(If additional description is necessary, use BACK of this sheet)

Name of Plugging Contractor L. C. Smitherman Drilling Company

Address Box 627 - Augusta, Kansas

STATE OF Kansas, COUNTY OF Butler ss.  
Joe W. Cain (employee of owner) or (owner) of the above-described

well, being first duly sworn on oath, says: That I have knowledge of the facts, statements, and matters herein contained and the log of the above-described well as filed and that the same are true and correct. So help me God.

(Signature) Joe W. Cain

Box 627 - Augusta, Kansas (Address)

SUBSCRIBED AND SWORN TO before me this 5th day of September, 19 56

Ruth A. Carter (Notary Public)

My commission expires October 23, 1958.

PLUGGING  
FILE SEC. 29 T. 27 R. 14W  
BOOK PAGE 97 LINE 7

IVAN ADAMS #1

Company - Parker Petroleum Co., Inc.  
 Contractor - L. C. Smitherman Drlg. Co.  
 Commenced - 8-13-56  
 Completed - 9-3-56  
 Total Depth - 4605'  
 Initial Prod. - D & A

Location: NW NW SE, Section 29-27S-14W, Pratt County, Kansas  
 Elevation: 2006 GL 2011 KB  
 Casing: 10 3/4" - 353 Cemented W/275 Sacks.

Figures Indicate Bottoms of Formations:

Depth	Formation	Depth	Formation
0 - 85	Sand & Shale	4480 - 4500	Shale (Simpson)
85 - 110	Sand	4500 - 4512	Sand & Chert
110 - 160	Shale & Shells	4512 - 4514	Sand & Cherty Shale
160 - 180	Sand & Shale	4514 - 4550	Lime & Chert W/Shale
180 - 367	Shale & Red Bed	4550 - 4585	Lime & Chert
367 - 850	Shale W/Sand Strks.	4585 - 4605	Lime (Arbuckle)
850 - 1063	Shale, Shells & Red Bed	4605 - R. T. D.	
1063 - 1445	Shale, Sand & Lime Shells		
1445 - 1905	Shale W/Lime Strks.		
1905 - 1950	Lime & Shale		
1950 - 1980	Shale		
1980 - 2165	Lime (Rt. Riley)		
2165 - 2256	Lime & Shale		
2256 - 2375	Lime		
2375 - 2410	Shale W/Lime Strks.		
2410 - 2445	Lime W/Shale Brks.		
2445 - 2532	Lime W/Shale		
2532 - 2560	Lime W/Sand Strks.		
2560 - 2610	Shale & Shells		
2610 - 2730	Shale W/Lime Strks.		
2730 - 2798	Lime W/Shale		
2798 - 2815	Shale W/Sand Strks.		
2815 - 3166	Shale & Lime		
3166 - 3175	Sand Hard		
3175 - 3315	Shale & Lime		
3315 - 3406	Shale W/Lime		
3406 - 3486	Lime		
3486 - 3541	Lime W/Shale Brks.		
3541 - 3725	Lime		
3725 - 3768	Lime W/Shale		
3768 - 3915	Shale & Lime		
3915 - 3929	Lime (Lansing)		
3929 - 3968	Lime W/Shale		
3968 - 4111	Lime		
4111 - 4127	Lime W/Shale		
4127 - 4325	Lime (K.C.)		
4325 - 4351	Lime & Shale		
4351 - 4460	Lime (Mississippi)		
4460 - 4480	Viola		

We hereby certify the above and foregoing to be a true and correct copy of the Log on the Ivan Adams #1, located in the NW NW SE, Section 29-27S-14W, Pratt County, Kansas.

L. C. SMITHERMAN DRILLING COMPANY

*Joe W. Coles*

Subscribed and sworn to before me this 6th day of September, 1956.

*Keith J. Carter*

Notary Public

My commission expires October 23, 1958.

**PLUGGING**  
 SEC 29 T 27 R 14W  
 BOOK PAGE 97 LINE 7