


STATE OF KANSAS  
STATE CORPORATION COMMISSION

Form CP-4

Give All Information Completely  
Make Required Affidavit  
Mail or Deliver Report to:  
Conservation Division  
State Corporation Commission  
211 No. Broadway  
Wichita, Kansas

## WELL PLUGGING RECORD

NORTH

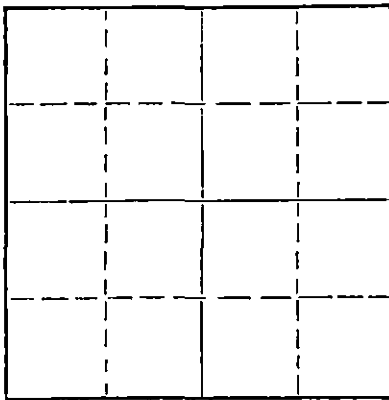

Locate well correctly on above  
Section Plat

Pratt County, Sec. 22 Twp. 27S Rge. (E) 14 (W)  
Location as "NE/CNW/SW" or footage from lines C SE 1/4 NE  
Lease Owner Ferguson Oil Company & Graves Drilling Co., Inc.  
Lease Name Peters Well No. 1  
Office Address 522 Union Center, Wichita, Kansas  
Character of Well (completed as Oil, Gas or Dry Hole) Dry Hole  
Date well completed July 6, 1963  
Application for plugging filed July 6, 1963  
Application for plugging approved July 6, 1963  
Plugging commenced July 6, 1963  
Plugging completed July 6, 1963  
Reason for abandonment of well or producing formation

If a producing well is abandoned, date of last production 19  
Was permission obtained from the Conservation Division or its agents before plugging was commenced? Yes

Name of Conservation Agent who supervised plugging of this well Archie V. Elving, Pratt, Kansas  
Producing formation Depth to top Bottom Total Depth of Well 4565 Feet  
Show depth and thickness of all water, oil and gas formations.

## OIL, GAS OR WATER RECORDS

## CASING RECORD

FORMATION	CONTENT	FROM	TO	SIZE	PUT IN	PULLED OUT

Describe in detail the manner in which the well was plugged, indicating where the mud fluid was placed and the method or methods used in introducing it into the hole. If cement or other plugs were used, state the character of same and depth placed, from feet to feet for each plug set.

Mudded up with heavy mud to 240 feet. Followed by wooden plug and 1/4 sack hulls. Placed 20 sacks cement onto hulls. Mudded up with heavy mud to 40 feet. Followed by wooden plug, 1/4 sack hulls and 15 sacks cement to base of well cellar. Plugged rat hole with 2 sacks cement.

RECEIVED  
STATE CORPORATION COMMISSION

JUL 10 1963 07-10-63

CONSERVATION DIVISION  
Wichita, Kansas

(If additional description is necessary, use BACK of this sheet)  
Name of Plugging Contractor Graves Drilling Co., Inc.  
Address Box 332, El Dorado, Kansas

STATE OF KANSAS, COUNTY OF BUTLER, ss.  
JOHN C. GRAVES (employee of owner) or (owner or operator) of the above-described

well, being first duly sworn on oath, says: That I have knowledge of the facts, statements, and matters herein contained and the log of the above-described well as filed and that the same are true and correct. So help me God.

(Signature)

Box 332, El Dorado, Kansas  
(Address)

SUBSCRIBED AND SWORN TO before me this 8th day of July, 1963

My commission expires April 30, 1967

Betty Brandt  
Notary Public.

INVOICED

DATE 7/10/63

INV. NO. 7388-W

R O T A R Y D R I L L E R S ' L O G

OPERATOR: Ferguson Oil Company &  
Graves Drilling Co., Inc.  
522 Union Center, Wichita, Kansas

DRILLING COMMENCED: June 24, 1963

CONTRACTOR: Graves Drilling Co., Inc.  
Box 332, El Dorado, Kansas

DRILLING COMPLETED: July 6, 1963

CASING RECORD: 10 Jts. - 12 1/4' - new 8-5/8"  
casing with 500 sacks of  
cement

LOCATION: Peters No. 1  
C SE NW  
Section 22-27S-14W  
Pratt County, Kansas

-----

0 - 130	Sand
130 - 195	Sand & gravel
195 - 650	Red rock, sand streaks & shale
650 - 1094	Shale
1094 - 1400	Shale & shells
1400 - 2030	Shale
2030 - 2345	Lime
2345 - 3280	Shale & lime
3280 - 3445	Shale
3445 - 3633	Shale & lime
3633 - 3751	Shale
3751 - 3870	Shale & lime
3870 - 3909	Shale
3909 - 4358	Lime
4358 - 4381	Lime & shaley
4381 - 4399	Chert
4399 - 4457	Lime
4457 - 4486	Cherty lime
4486 - 4545	Lime
4545 - 4565	Shale & sand
4565	Rotary Total Depth

RECEIVED  
STATE CORPORATION COMMISSION

JUL 10 1963

CONSERVATION DIVISION  
Wichita, Kansas

I hereby certify the foregoing statements to be true and correct to the best of my knowledge.

GRAVES DRILLING CO., INC.

By Phil Graves  
President

STATE OF KANSAS     )  
                          )     SS  
BUTLER COUNTY     )

Subscribed and sworn to before me, a Notary Public, this 8th day of July, 1963.

My commission expires: April 30, 1967

Betty Brandt  
Betty Brandt     Notary Public