

STATE OF KANSAS  
STATE CORPORATION COMMISSION

WELL PLUGGING RECORD


Give All Information Completely  
Make Required Affidavit  
Mail or Deliver Report to:  
Conservation Division  
State Corporation Commission  
800 Bittling Building  
Wichita, Kansas

OR  
FORMATION PLUGGING RECORD

Strike out upper line  
when reporting plug-  
ging of formations.

Pratt County. Sec. 13 Twp. 27S Rge. (E) 14 (W)

Location as "NE $\frac{1}{4}$ NW $\frac{1}{4}$ SW $\frac{1}{4}$ " or footage from lines SW NE SW  
Lease Owner Lario Oil & Gas Company  
Lease Name Moon Well No. 1  
Office Address 301 South Market, Wichita 2, Kansas  
Character of Well (completed as Oil, Gas or Dry Hole) Dry Hole  
Date well completed March 13, 1954  
Application for plugging filed (Written) March 15, 1954  
Application for plugging approved March 15, 1954  
Plugging commenced March 13, 1954  
Plugging completed March 13, 1954  
Reason for abandonment of well or producing formation Dry

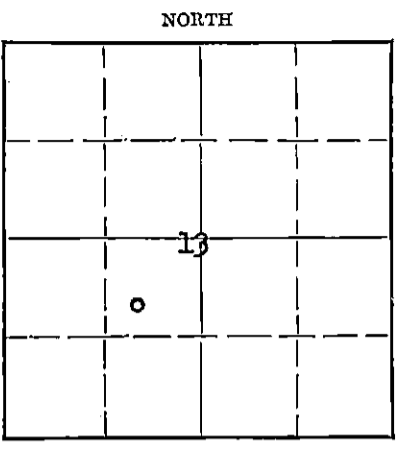

Locate well correctly on above  
Section Plat

If a producing well is abandoned, date of last production 19...  
Was permission obtained from the Conservation Division or its agents before plugging was com-  
menced? Yes

Name of Conservation Agent who supervised plugging of this well M. A. Rives, Pratt, (Kansas)  
Producing formation Depth to top Bottom Total Depth of Well 4655 Feet  
Show depth and thickness of all water, oil and gas formations.

OIL, GAS OR WATER RECORDS CASING RECORD

Formation	Content	From	To	Size	Put In	Pulled Out
				8 5/8"	412.77'	None

Describe in detail the manner in which the well was plugged, indicating where the mud fluid was placed and the method or methods used in introducing it into the hole. If cement or other plugs were used, state the character of same and depth placed, from...feet to...feet for each plug set.

Set plug at 300' and cemented with 20 sacks of cement down the drill pipe. Set plug at 30' and cemented with 10 sacks cement.

(If additional description is necessary, use BACK of this sheet)

Correspondence regarding this well should be addressed to Leo Ross, Lario Oil & Gas Company  
Address 301 South Market, Wichita 2, Kansas

STATE OF KANSAS, COUNTY OF SEDGWICK, ss.

(employee of owner) or (owner or operator) of the above-described well, being first duly sworn on oath, says: That I have knowledge of the facts, statements, and matters herein contained and the log of the above-described well as filed and that the same are true and correct. So help me God.

(Signature) [Signature] RECEIVED STATE CORPORATION COMMISSION

SUBSCRIBED AND SWORN to before me this 18th day of March 1954

Grances [Signature] Notary Public.

My commission expires July 21, 1954

PLUGGING  
FILE SEC 13 T 27 R 14 W  
BOOK PAGE 19 LINE 24

03-19-54

DRILLERS LOG

*Comp.  
Comm.*

Owner-Operator:

Lario Oil & Gas Company  
301 S. Market, Wichita, Kansas

Re: MOON #1

SW NE SW 13-27s-14w,  
Pratt Co., Kansas

Contractor:

W. J. Coppinger  
320 Union National Bank Bldg.  
Wichita, Kansas

Casing Record:

Set 8-5/8" @ 408' w/250 sx posmix and  
3 sx chloride

Tops:

Clay Sand & Gravel	200
Red Bed	905
Anhydrite	950
Red Bed, Shale & Shells	995
Shale & Shells	1865
Lime	2095
Lime & Shale	2250
Lime	2375
Lime & Shale	2455
Lime	2560
Shale & Lime	2685
Shale	2870
Shale & Lime	3015
Shale	3090
Shale & Lime	3240
Lime	3290
Shale & Lime	3395
Lime	3475
Lime & Shale	3610
Lime	3655
Shale & Lime	3890
Lime	3915
Lime & Shale	4015
Lime	4125
Lime & Shale	4146
Lime	4160
Lime & Shale	4360
Chert & Shale	4395
Cherty Lime & Shale	4402
Shale & Lime	4435
Chert & Shale	4469
Cherty Lime & Shale	4490
Cherty Lime	4499
Shale & Lime	4515
Cherty Lime & Shale	4545
Shale & Lime	4555
Sand & Shale	4594
Lime & Shale	4645
Lime	4655
Total Depth	4655
Dry & Abandoned	

<u>Formation</u>	<u>Sample</u>	<u>Schlumberger Tops.</u>
Anhydrite	905	905
Topeka	3305	3274
Heebner	3658	3716
Douglas	3700	3750
Brown Lime	3874	3871
Kansas City	3897	3893
Mississippi	4325	4325
Kinderhook	4364	
Viola	4377	4373
Simpson	4455	4522
Arbuckle	4613	4613
RTD	4655	4651
D & A		

Commenced: February 16, 1954  
Completed: March 15, 1954  
Elevation: 1979 D.F.  
1976 G.L.

STATE OF KANSAS )  
SEDGWICK COUNTY ) SS:

I, the undersigned, being duly sworn on oath, state that the above statement and log is a true record and log of the well drilled at the location above described.

*Lee Paulson*  
Subscribed and sworn to before me this 15th day of March, 1954.  
*Joseph Brown*  
Notary Public  
My commission expires March 7, 1959

RECEIVED  
CONSERVATION COMMISSION  
MAR 19 1954  
CONSERVATION DIVISION  
Wichita, Kansas

**PLUGGING**  
FILE SEC 13 T 27 R 14W  
BOOK PAGE 19 LINE 24