


WELL PLUGGING RECORD

Give All Information Completely  
Make Required Affidavit  
Mail or Deliver Report to:  
Conservation Division  
State Corporation Commission  
212 No. Market  
Wichita, Kansas

NORTH

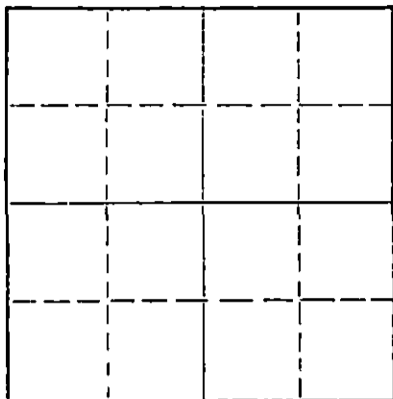

Locate well correctly on above  
Section Plat

Pratt County, Sec. 7 Twp. 27S Rge. (E) 14 (W)  
Location as "NE/CNWxSWx" or footage from lines C/SW NW  
Lease Owner Strata Drilling, Inc.  
Lease Name Commercial Jones Well No. 1  
Office Address P. O. Box 355, Great Bend, Kansas 67530  
Character of Well (completed as Oil, Gas or Dry Hole) Dry Hole  
Date well completed January 29 19 68  
Application for plugging filed January 29 19 68  
Application for plugging approved January 29 19 68  
Plugging commenced January 29 19 68  
Plugging completed January 29 19 68  
Reason for abandonment of well or producing formation Dry Hole

If a producing well is abandoned, date of last production 19  
Was permission obtained from the Conservation Division or its agents before plugging was commenced? Yes

Name of Conservation Agent who supervised plugging of this well Archie Elving, Pratt, Kansas  
Producing formation Depth to top Bottom Total Depth of Well 4625 Feet  
Show depth and thickness of all water, oil and gas formations.

OIL, GAS OR WATER RECORDS

CASING RECORD

FORMATION	CONTENT	FROM	TO	SIZE	PUT IN	PULLED OUT
	8-5/8"	0	324.98'			

Describe in detail the manner in which the well was plugged, indicating where the mud fluid was placed and the method or methods used in introducing it into the hole. If cement or other plugs were used, state the character of same and depth placed, from feet to feet for each plug set.

Plugged hole as follows: plugged at 275' with 25 sacks of cement and mud to 40'; bridged with hulls and plug and 10 sacks of cement, two sacks of cement in rat hole and 2 sacks of cement in mouse hole. Plug down at 10:30 A. M. January 29, 1968.

RECEIVED  
STATE CORPORATION COMMISSION  
FEB 1 - 1968  
CONSERVATION DIVISION  
Wichita, Kansas  
2-1-68

(If additional description is necessary, use BACK of this sheet)


Name of Plugging Contractor Strata Drilling, Inc.  
Address P. O. Box 355, Great Bend, Kansas 67530

STATE OF KANSAS, COUNTY OF BARTON, ss.  
Jim B. McWilliams (employee of owner) or (SUPERVISOR) of the above-described

well, being first duly sworn on oath, says: That I have knowledge of the facts, statements, and matters herein contained and the log of the above-described well as filed and that the same are true and correct. So help me God.

(Signature) Jim B. McWilliams  
Jim B. McWilliams, Secy-Treas.  
P. O. Box 355, Great Bend, Kansas 67530  
(Address)

Subscribed and sworn to before me this 31st day of January, 19 68

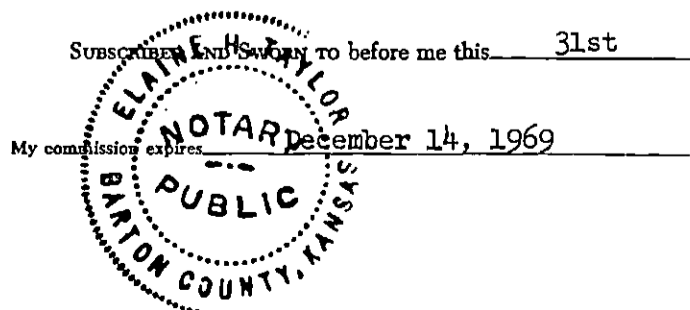

Elaine H. Taylor  
Elaine H. Taylor Notary Public.

D R I L L E R S   L O G

#1 Commercial Jones

CASING RECORD:  
324.98' of new 8-5/8"  
surface casing.

COMPANY:      Strata Drilling, Inc.  
CONTRACTOR:   Strata Drilling, Inc.

DESCRIPTION:   C/SW NW  
Section 7-27S-14W  
Pratt County, Kansas

TOTAL DEPTH:  
4625'

COMMENCED:    January 17, 1968  
COMPLETED:   January 29, 1968

ELEVATION:    2028' DF

D. & A.

<u>FORMATION</u>	<u>FROM</u>	<u>TO</u>	<u>REMARKS</u>
Sand & Surf Clay & Shale	0	710	Ran 324.98' of new 8-5/8" surface casing; set and cemented at 324.98' with 220 sacks of hot cement and 2% gel. Plug down at 7:45 A. M. January 18, 1968.
Shale & Shells	710	943	
Anhydrite	943	963	
Shale & Shells	963	2046	
Shale & Lime	2046	3710	
Shale	3710	3900	
Lime & Shale	3900	4041	
Lime	4041	4505	
Cherty Lime	4505	4625	

Total Depth 4625'

RECEIVED  
STATE CORPORATION COMMISSION  
FEB 1 - 1968  
CONSERVATION DIVISION  
Wichita, Kansas

D. & A.

Plugged hole as follows: plugged at 275' with 25 sacks of cement and mud to 40'; bridged with hulls and plug and 10 sacks of cement, two sacks of cement in rat hole and two sacks of cement in the mouse hole. Plug down at 10:30 A. M. January 29, 1968.

STATE OF KANSAS )  
                          ) ss.  
COUNTY OF BARTON )

I certify that this is a true and correct copy of the above log to the best of my knowledge.

STRATA DRILLING, INC.

*Jim B. McWilliams*  
Jim B. McWilliams, Secy-Treas.

Subscribed and sworn to before me this 31st day of January, 1968.

NOTARY PUBLIC  
ELAINE H. TAYLOR  
My Commission Expires:  
December 31, 1969

*Elaine H. Taylor*  
Elaine H. Taylor, Notary Public