

9

STATE OF KANSAS  
STATE CORPORATION COMMISSION

Form CP-4


Give All Information Completely  
Make Required Affidavit  
Mail or Deliver Report to:  
Conservation Division  
State Corporation Commission  
212 No. Market  
Wichita, Kansas

WELL PLUGGING RECORD

Pratt County, Sec. 7 Twp. 27S Rge. 14W (E)SE/4W

Location as "NE/CNW%SW%" or footage from lines 440' N of S 1, 440' E of W 1  
Lease Owner Amarillo Natural Gas Company  
Lease Name Jones Well No. 1  
Office Address 305 Bank of the Southwest, Amarillo, Texas 79109  
Character of Well (completed as Oil, Gas or Dry Hole) Dry Hole  
Date well completed August 15 1967  
Application for plugging filed August 15 1967  
Application for plugging approved August 16 1967  
Plugging commenced August 16 1967  
Plugging completed August 16 1967  
Reason for abandonment of well or producing formation Dry Hole

NORTH

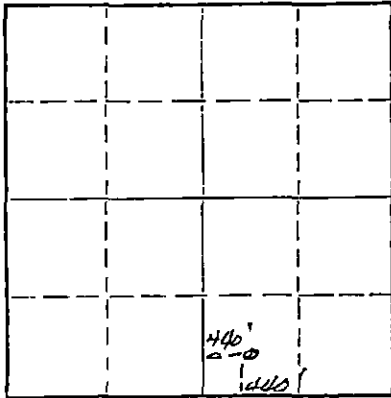

Locate well correctly on above Section Plat

If a producing well is abandoned, date of last production None 19\_\_  
Was permission obtained from the Conservation Division or its agents before plugging was commenced? Yes

Name of Conservation Agent who supervised plugging of this well Archie E. Elwing, Pratt, Kansas  
Producing formation None Depth to top          Bottom          Total Depth of Well 4684 Feet  
Show depth and thickness of all water, oil and gas formations.

OIL, GAS OR WATER RECORDS

CASING RECORD

FORMATION	CONTENT	FROM	TO	SIZE	PUT IN	PULLED OUT
Surface		0	338	8-5/8"	338	None

Describe in detail the manner in which the well was plugged, indicating where the mud fluid was placed and the method or methods used in introducing it into the hole. If cement or other plugs were used, state the character of same and depth placed, from          feet to          feet for each plug set.

Plug @ 250' w/35 Sacks cement; plug @ 40' to surface w/10 sacks cement,

RECEIVED  
THE CORPORATION COMMISSION  
AUG 21 1967  
8-21-67  
CONSERVATION DIVISION  
Wichita, Kansas

(If additional description is necessary, use BACK of this sheet)

Name of Plugging Contractor Mahoney Drilling Co., Inc.  
Address P. O. Box 1257, Liberal, Kansas 67901

STATE OF Texas, COUNTY OF Potter, ss.  
L. E. Geoffroy (~~employee of~~ operator) of the above-described

well, being first duly sworn or oath, says: That I have knowledge of the facts, statements, and matters herein contained and the log of the above-described well as filed and that the same are true and correct. So help me God.

(Signature) [Signature]  
L. E. Geoffroy, Vice President  
305 Bank of the Southwest, Amarillo, Texas 79109  
(Address)

SUBSCRIBED AND SWORN TO before me this 18th day of August, 1967

[Signature]  
Notary Public.

My commission expires 6-1-69

69

DRILLER'S LOG

Well Owner: Amarillo Natural Gas Company  
Farm Name: Jones #1  
Date Started: 8-1-67  
Date Completed: 8-16-67  
Total Depth: 4684

SW SE  
Section 7-27S-14W  
Pratt County, Kansas

Casing: 8-5/8" casing set at 236' cemented

Contractor: Peel Brothers, Inc.

Bottoms of formations are as follows -

Surface Sand	0 - 40
Sand	120
Shale and Sand	270
Red Bed and Shale	340
Shale and Red Bed	400
Shells and Shale	670
Anhydrite	936
Shale and Shells	1750
Shale	2055
Lime and Shale	3685
Lime and Chert	4461
Lime	4605
Shale and Lime	4684
Total Depth	4684

RECEIVED  
STATE CORPORATION COMMISSION

AUG 25 1967

CONSERVATION DIVISION  
Wichita, Kansas

This is to certify that the above information is to the best of our knowledge true and correct.

PEEL BROTHERS, INC.

*Wendell C. Peel*  
Wendell C. Peel  
President



SUBSCRIBED TO AND SWORN to before me this 18th day of August, 1967.

*Ethel S. Williamson*  
Ethel S. Williamson  
Notary Public

My Commission expires 6-21-70