


STATE OF KANSAS  
STATE CORPORATION COMMISSION  
CONSERVATION DIVISION  
P. O. BOX 17027  
WICHITA, KANSAS 67217

FORM CP-4

WELL PLUGGING RECORD

Pratt County, Sec. 7 Twp. 27 Rge. 14 (E) (W)

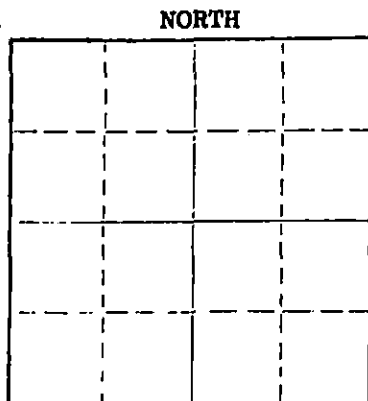

Location as "NE/CNW/SW" or footage from lines SW SW SW  
Lease Owner Vincent Oil Co.  
Lease Name Jones #1 Well No.  
Office Address Wichita, Kansas 67202  
Character of Well (completed as Oil, Gas or Dry Hole)  
Date well completed 19  
Application for plugging filed 19  
Application for plugging approved 19  
Plugging commenced 12/29/75 19  
Plugging completed 1/8/76 19  
Reason for abandonment of well or producing formation depleted.

If a producing well is abandoned, date of last production 19  
Was permission obtained from the Conservation Division or its agents before plugging was commenced? Yes

Name of Conservation Agent who supervised plugging of this well Biberstein  
Producing formation Depth to top Bottom Total Depth of Well 4690 Feet  
Show depth and thickness of all water, oil and gas formations.

OIL, GAS OR WATER RECORDS

CASING RECORD

FORMATION	CONTENT	DATE FROM	TD	SIZE	PUT IN	PULLED OUT
				8-5/8	230	none
				4 1/2"	4687	2246
		JAN 21 1976				
		1-21-76				
		WICHITA, KANSAS				

Describe in detail the manner in which the well was plugged, indicating where the mud fluid was placed and the method or methods used in introducing it into the hole. If cement or other plugs were used, state the character of same and depth placed, from feet to feet for each plug set.

Pushed plug to 3900' and dumped 4 sacks cement. Loaded hole with 40 barrels salt water, ran 50' sand and 4 more sacks cement. Loaded hole, shot pipe at 3355', fluid was at 1399', mud came in to 2564'. Checked hole, mud was to 2465', Halliburton pumped 120 barrels salt water, shot pipe at 3125', 203 3024', 2921', 2821', 2720', 2421', 2260', worked pipe loose and pulled 69 joints. Set rock bridge at 200' and dumped 25 sacks cement, mud to 40', 10' rock bridge ant ran 10 sacks cement.

PLUGGING COMPLETE. (If additional description is necessary, use BACK of this sheet)

Name of Plugging Contractor KNIGHT CASING PULLING CO., INC.  
Address CHASE, KANSAS

STATE OF KANSAS COUNTY OF RICE  
NOEL J. KNIGHT (employee of owner) or (owner or operator) of the above-described

well, being first duly sworn on oath, says: That I have knowledge of the facts, statements, and matters herein contained and the log of the above-described well as filed and that the same are true and correct. So help me God.

(Signature) Noel Knight  
CHASE, KANSAS

Subscribed and sworn to before me this 12th day of January (Address) 76 19

Margaret Melcher  
Notary Public.

My commission expires  
NOTARY PUBLIC  
MARGARET MELCHER  
Rice County, Ks.  
My Comm. Exp. Feb. 15, 1979