


Give All Information Completely
Make Required Affidavit
Mail or Deliver Report to:
Conservation Division
State Corporation Commission
211 No. Broadway
Wichita, Kansas

WELL PLUGGING RECORD

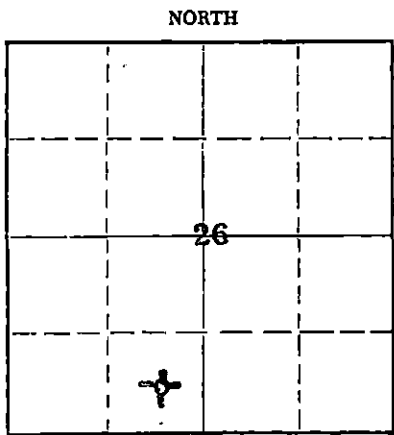

Locate well correctly on above
Section Plat

Pratt County. Sec. 26 Twp. 27S Rge. 13W (W)

Location as "NE/CNW&SW%" or footage from lines C SE SW

Lease Owner Richard L. Bohanon

Lease Name Montford Well No. 1

Office Address 1617 Bedford Drive, Oklahoma City, Oklahoma

Character of Well (completed as Oil, Gas or Dry Hole) Dry Hole

Date well completed August 30, 1964

Application for plugging filed August 30, 1964

Application for plugging approved August 30, 1964

Plugging commenced August 30, 1964

Plugging completed August 30, 1964

Reason for abandonment of well or producing formation Dry Hole

If a producing well is abandoned, date of last production _____ 19____

Was permission obtained from the Conservation Division or its agents before plugging was commenced? Yes

Name of Conservation Agent who supervised plugging of this well A. Elving

Producing formation _____ Depth to top _____ Bottom _____ Total Depth of Well 4475 Feet

Show depth and thickness of all water, oil and gas formations.

OIL, GAS OR WATER RECORDS

CASING RECORD

FORMATION	CONTENT	FROM	TO	SIZE	PUT IN	PULLED OUT
		0	303	8-5/8"	303	None

Describe in detail the manner in which the well was plugged, indicating where the mud fluid was placed and the method or methods used in introducing it into the hole. If cement or other plugs were used, state the character of same and depth placed, from _____ feet to _____ feet for each plug set.

Hole filled with Mud 4475-290

Plug 290-286

25 sacks Cement 286-40

Plug 40-36

10 sacks Cement 36-6' Bottom of Cellar

RECEIVED
STATE CORPORATION COMMISSION

SEP 17 1964

09-17-64
CONSERVATION DIVISION
Wichita, Kansas

(If additional description is necessary, use BACK of this sheet)

Name of Plugging Contractor Globe Cementing Co.

Address Great Bend, Kansas

STATE OF KANSAS, COUNTY OF SEDGWICK, ss.

John H. Knightley (employee of owner) or (owner or operator) of the above-described well, being first duly sworn on oath, says: That I have knowledge of the facts, statements, and matters herein contained and the log of the above-described well as filed and that the same are true and correct. So help me God.

(Signature) John H. Knightley
301 S. Broadway, Wichita, Kansas
(Address)

SUBSCRIBED AND SWORN TO before me this 15th day of September, 19 64

My commission expires March 12, 1967 Stella J. Lippa Notary Public.

Richard L. Bohanon

Montford #1

C SE SW Sec. 26-27S-13W
Pratt County, Kansas

Commenced: August 15, 1964

Completed: August 30, 1964

Rotary Drilling Contractor: Lauck Drilling Company, Incorporated.

Casing Record: 303' 8-5/8" Cemented with 225 sacks Cement,
4 sacks Calcium Chloride.

Elevation: GL 1904; DF 1907; KB 1909

Drillers Log

Clay	15
Sand	165
Clay & Red Bed	303
Red Bed & Shale	420
Sand & Red Bed	800
Red Bed & Shale	1790
Lime & Shale	2133
Shale & Lime	2310
Lime	2400
Lime & Shale	2805
Shale & Lime	3120
Lime	3240
Broken Lime	3440
Shale & Lime	3465
Lime & Shale	3490
Broken Lime & Shale	3560
Shale & Lime	3845
Lime	4310
Chert & Lime	4340
Coring	4345
Core #2	4350
Sandy Shale	4358
Sand & Shale	4400
Sand, Shale, Chert	4435
Shale & Lime	4475 RTD

RECEIVED
STATE CORPORATION COMMISSION

SEP 17 1964

CONSERVATION DIVISION
Wichita, Kansas

I hereby certify that this is a true and correct
log of the above mentioned well, to the best
of my knowledge and belief.

John A. Knightley
Subscribed and sworn to before me this

15th day of September, 1964

Stella J. Lippe
Notary Public

My commission expires 3-12-67