

STATE OF KANSAS
STATE CORPORATION COMMISSION


WELL PLUGGING RECORD

Give All Information Completely
Make Required Affidavit
Mail or Deliver Report to:
Conservation Division
State Corporation Commission
211 No. Broadway
Wichita, Kansas

Pratt County. Sec. 24 Twp. 27 Rge. 13 ~~22~~ (W)

Location as "NE/CNW/SW" or footage from lines SE NW NW
Lease Owner Hilton Drilling Company, Inc.
Lease Name Swingle Well No. 1
Office Address P.O. Box 108, Great Bend, Kansas
Character of Well (completed as Oil, Gas or Dry Hole) dry hole
Date well completed December 23, 1957
Application for plugging filed December 23, 1957
Application for plugging approved December 23, 1957
Plugging commenced December 23, 1957
Plugging completed December 23, 1957
Reason for abandonment of well or producing formation dry

NORTH

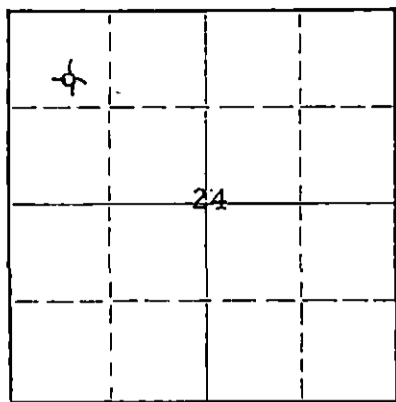

Locate well correctly on above
Section Plat

If a producing well is abandoned, date of last production _____ 19____
Was permission obtained from the Conservation Division or its agents before plugging was commenced? yes

Name of Conservation Agent who supervised plugging of this well W. H. Brundage
Producing formation _____ Depth to top _____ Bottom _____ Total Depth of Well 4350 Feet
Show depth and thickness of all water, oil and gas formations.

OIL, GAS OR WATER RECORDS

CASING RECORD

FORMATION	CONTENT	FROM	TO	SIZE	PUT IN	PULLED OUT
				8-5/8"	308	none

Describe in detail the manner in which the well was plugged, indicating where the mud fluid was placed and the method or methods used in introducing it into the hole. If cement or other plugs were used, state the character of same and depth placed, from _____ feet to _____ feet for each plug set.

Filled hole with drilling mud to 300' and set plug with 20 sacks cement, filled to 35' and set plug with 15 sacks cement.

RECEIVED
STATE CORPORATION COMMISSION
DEC 28 1957
CONSERVATION DIVISION
Wichita, Kansas

12-28-57

(If additional description is necessary, use BACK of this sheet)

Name of Plugging Contractor Hilton Drilling Company, Inc.
Address Great Bend, Kansas

STATE OF KANSAS, COUNTY OF BARTON, ss.
Jack L. Craft, Ass't. Secretary (employee of owner) or (owner or operator) of the above-described well, being first duly sworn on oath, says: That I have knowledge of the facts, statements, and matters herein contained and the log of the above-described well as filed and that the same are true and correct. So help me God.

(Signature) Jack L. Craft
Great Bend, Kansas
(Address)

SUBSCRIBED AND SWORN to before me this 24th day of December, 1957

MILDRED HOBBIIE
My commission expires MY COMMISSION EXPIRES MARCH 6, 1958

Mildred Hobbie
Notary Public.

PLUGGING
FILE SEC. 24 T. 27 R. 13W
BOOK PAGE 72 LINE 14

DRILLER'S LOG

COMPANY: Hilton Drilling Company, Inc.
 CONTRACTOR: Hilton Drilling Company, Inc.
 FARM NAME: Swingle No. 1
 COMMENCED: December 8, 1957
 COMPLETED: December 23, 1957

LOCATION: SE NW NW
 Sec. 24-27S-13W
 Pratt County, Kansas
 ELEVATION: 1911 D.F.

Casing Used: 8-5/8" set @ 308' w/250 sacks

Clay and Sand	130
Red Bed and Shale	680
Anhydrite	740
Shale and Shells	1575
Ft. Riley Lime	1580
Lime	2010
Shale	2035
Florence Flint	2060
Shale and Lime	2415
Lime	2485
Shale and Lime	3340
Lime	3540
Shale and Lime	3635
Shale and Sand	3720
Shale and Lime	3800
Lime	4103
Shale and Lime	4150
Lime	4212
Shale and Chert	4245
Lime	4255
Lime and Chert	4295
Simpson Shale	4302
Shale and Sand	4312
Lime and Chert	4334
Shale and Sand	4350
Total Depth	4350

RECEIVED
 STATE CORPORATION COMMISSION
 DEC 28 1957
 CONSERVATION DIVISION
 Wichita, Kansas

STATE OF KANSAS)
) SS.
 COUNTY OF BARTON)

I, the undersigned, being duly sworn on oath, state that the above-statement and log are true and a correct record and log of the well drilled at the location above-described.

PLUGGING
 FILE SEC 24T 27 R 13W
 BOOK PAGE 72 LINE 14

HILTON DRILLING COMPANY, INC.

Jack L. Craft
 Jack L. Craft, Assistant Secretary

Subscribed and sworn to before me this 24th day of December, 1957

MILDRED HOBBIÉ
 MY COMMISSION EXPIRES MARCH 6, 1958

Mildred Hobbie
 Notary Public