

STATE OF KANSAS
STATE CORPORATION COMMISSION


Give All Information Completely
Make Required Affidavit
Mail or Deliver Report to:
Conservation Division
State Corporation Commission
800 Biting Building
Wichita, Kansas

WELL PLUGGING RECORD

Pratt County, Sec. 24 Twp. 27 Rge. (E) 13 (W)

Location as "NE/CNW/SW" or footage from lines SW NW SW
Lease Owner Graham-Messman-Rinehart Drilling Company
Lease Name McGuire Well No. 1
Office Address 1005 E. Second St., Wichita, Kansas
Character of Well (completed as Oil, Gas or Dry Hole) Dry Hole
Date well completed August 10, 19 53
Application for plugging filed August 10, 19 53
Application for plugging approved August 10, 19 53
Plugging commenced August 11, 19 53
Plugging completed August 11, 19 53
Reason for abandonment of well or producing formation Dry Hole

NORTH

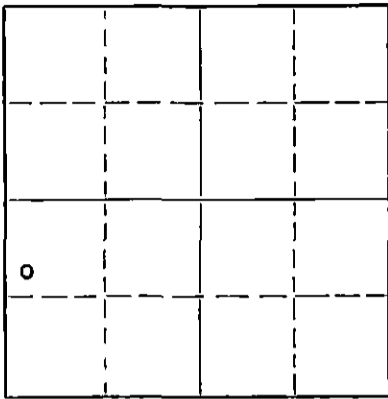

Locate well correctly on above
Section Flat

If a producing well is abandoned, date of last production 19
Was permission obtained from the Conservation Division or its agents before plugging was commenced? yes

Name of Conservation Agent who supervised plugging of this well M. A. Rives, Box 118, Pratt, Kansas
Producing formation _____ Depth to top _____ Bottom _____ Total Depth of Well 445 Feet
Show depth and thickness of all water, oil and gas formations.

OIL, GAS OR WATER RECORDS

CASING RECORD

FORMATION	CONTENT	FROM	TO	SIZE	PUT IN	PULLED OUT
				8-5/8"	267'	none

Describe in detail the manner in which the well was plugged, indicating where the mud fluid was placed and the method or methods used in introducing it into the hole. If cement or other plugs were used, state the character of same and depth placed, from _____ feet to _____ feet for each plug set.

Plugged hole through drilling pipe,
cemented with 20 sx. Bottom plug
at 280 ft. Top plug at 40 ft. with
10 sx. cement. Mud to surface.

01-19-53

(If additional description is necessary, use BACK of this sheet)

Name of Plugging Contractor Graham-Messman-Rinehart Oil Company
Address P. O. Box 1033, Wichita, Kansas


STATE OF Kansas, COUNTY OF Sedgwick, ss.
J. A. Gilliland (employee of owner) of the above-described well, being first duly sworn on oath, says: That I have knowledge of the facts, statements, and matters herein contained and the log of the above-described well as filed and that the same are true and correct. So help me God.

(Signature) J. A. Gilliland
1005 E. Second St., Wichita, Kansas
(Address)

SUBSCRIBED AND SWORN TO before me this 18th day of August, 19 53

Barbara J. Scott
Notary Public.

My commission expires December 1, 1956

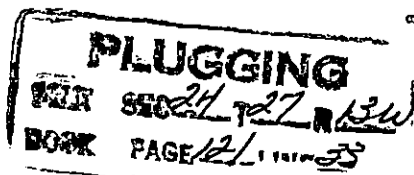

McGUIRE #1

WELL RECORD

Location: SW NE SW Sec. 24-27-13W
Pratt County, Kansas

Commenced: July 24, 1953

Completed: August 10, 1953

Operator: Graham-Messman-Rinehart Oil Co.
1005 E. Second Street
Wichita, Kansas

Elevation: 1914 K.B.

Production: D & A

Contractor: Graham-Messman-Rinehart Oil Co.

Casing Record: 8 5/8" @ 267' w/180 sx's Cem. & 4 c.c.

L O G

Sand & Clay	261
Clay & Shale	267
Shale - Shells	1100
Shale - Shells	1800
Shale - Lime	1960
Shale - Lime	1960
Shale - Lime	2162
Shale - Lime	2328
Shale - Lime	2458
Shale - Lime	2564
Shale - Lime	2788
Shale - Lime	2936
Shale - Lime	3010
Shale - Lime	3095
Shale - Lime	3265
Shale - Lime	3352
Shale - Lime	3457
Shale - Lime	3645
Shale - Lime	3755
Lime - Shale	3815
Lime	3847
Lime	3897
Lime	3948
Lime	3949
Lime	4000
Lime	4048
Lime	4085
Lime	4086
Lime	4140
Lime	4170
Lime - Chert	4192
Lime - Chert	4210
Lime - Chert	4216
Lime - Chert	4247
Lime - Chert	4264
Lime - Chert	4285
Lime - Chert	4317
Lime - Chert	4345
Lime - Shale	4378
Lime - Shale	4381
Lime - Sand - Shale	4394
Lime - Sand	4400
Lime - Shale	4405
Lime - Shale	4444
Lime - Shale	4455

TOPS:

Anhydrite	699	(-1215)
Haebner	3550	(-1636)
Toronto	3571	(-1657)
Douglas Sand	3624	(-1710)
Brown Lime	3763	(-1849)
Lansing	3784	(-1870)
Mississippi	4171	(-2257)
Simpson Shale	4313	(-2399)
Simpson Sand	4335	(-2421)
TD	4455	

RECEIVED
AUG 10 1953
OIL DIVISION
WICHITA, KANSAS

The undersigned, Graham-Messman-Rinehart Oil Company, hereby certifies that the above log is a true and correct log of the formation encountered in drilling the above well as reflected by the Daily Drilling Reports.

PLUGGING
FILE SEC 24-27-13W
BOOK PAGE 22 LINE 22

GRAHAM-MESSMAN-RINEHART OIL COMPANY

By: J. A. Gilliland
J. A. Gilliland

Subscribed and sworn to before me
this 14th day of August, 1953

Richard J. Scott
Notary Public

My Commission expires: Dec. 1, 1956