


STATE OF KANSAS
STATE CORPORATION COMMISSION

Form CP-4

Give All Information Completely
Make Required Affidavit
Mail or Deliver Report to:
Conservation Division
State Corporation Commission
212 No. Market
Wichita, Kansas

WELL PLUGGING RECORD

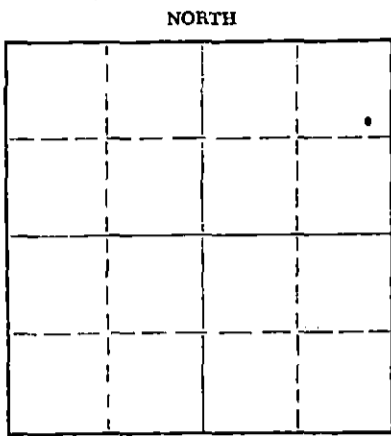

Locate well correctly on above
Section Plat

Pratt County, Sec. 24 Twp. 27 Rge. (E) 13(W)
Location as "NE/CNWxSWx" or footage from lines SE NE NE
Lease Owner The Bovaird Supply Company
Lease Name McGuire "D" Well No. 2
Office Address Box 48, Great Bend, Kansas
Character of Well (completed as Oil, Gas or Dry Hole) oil
Date well completed 19
Application for plugging filed May 10 1968
Application for plugging approved 19
Plugging commenced June 25 1968
Plugging completed June 28 1968
Reason for abandonment of well or producing formation depleted

If a producing well is abandoned, date of last production 19
Was permission obtained from the Conservation Division or its agents before plugging was commenced? yes

Name of Conservation Agent who supervised plugging of this well Ralph Warren
Producing formation Depth to top Bottom Total Depth of Well 4372 Feet
Show depth and thickness of all water, oil and gas formations.

OIL, GAS OR WATER RECORDS

CASING RECORD

FORMATION	CONTENT	FROM	TO	SIZE	PUT IN	PULLED OUT
		0	435'	8 5/8"	435'	none
		0	4372'	5 1/2"	4372'	3221.36

Describe in detail the manner in which the well was plugged, indicating where the mud fluid was placed and the method or methods used in introducing it into the hole. If cement or other plugs were used, state the character of same and depth placed, from feet to feet for each plug set.

Sand back from 4372' to 4300' and dumped 5 sacks cement.

Pushed plug to 390', set 10' rock bridge and dumped 25 sacks cement.
Filled hole with mud to 40', set 10' rock bridge and capped hole with 10 sacks cement.

RECEIVED
STATE CORPORATION COMMISSION
JUL 3 1968
CONSERVATION DIVISION
Wichita, Kansas

(If additional description is necessary, use BACK of this sheet)
Name of Plugging Contractor Pipe Pullers, Inc.
Address Box 486, Ellinwood, Kansas

STATE OF Kansas, COUNTY OF Barton, ss.
E. L. Schonhoff (employee of owner) or (owner or operator) of the above-described well, being first duly sworn on oath, says: That I have knowledge of the facts, statements, and matters herein contained and the log of the above-described well as filed and that the same are true and correct. So help me God.

(Signature) E. L. Schonhoff
Ellinwood, Kansas (Address)

SUBSCRIBED AND SWORN TO before me this 2nd day of July, 1968

My commission expires July 7, 1968 Notary Public.

Feb 1968

DRILLERS LOG

McGuire D #2

Casing: 8 5/8" O 435' w/300 Saz Foamix

Loc: SE NE NE

5 1/2" O 4372' w/150 Saz Common

Sec: 24-27S-13W

Pratt County, Kansas

Comm: 9-30-51

Comp: 10-16-51

Operator: Cooperative Refinery Ass'n.

R. T. D. 4372'

Contractor: Company Rig #5

From	To	Formation
0	355	Surface
355	435	Red Bed, Shale
435	1810	Shale & Shells
1810	1985	Shale & Lime
1985	2130	Lime
2130	3500	Lime & Shale
3500	3575	Lime
3575	3685	Lime & Shale
3685	3800	Lime
3800	3840	Lime & Shale
3840	4094	Lime
4094	4170	Lime & Chert
4170	4235	Lime & Shale
4235	4290	Lime & Chert
4290	4372	Lime & Shale
4372		R. T. D.

RECEIVED
 STATE CORPORATION COMMISSION
 MAY 13 1968
 CONSERVATION DIVISION
 Wichita, Kansas

(STATE OF KANSAS)

(COUNTY OF BARTON)

I hereby certify that the above is a true and correct copy of the log on the McGuire D #2 well, located SE NE NE of section 24-27S-13W, Pratt County, Kansas

P. H. Jackson

Subscribed and sworn to before me this 18 day of October 1954

Donald E. Hart

My commission expires August 17, 1957.