


STATE OF KANSAS
STATE CORPORATION COMMISSION

Give All Information Completely
Make Required Affidavit
Mail or Deliver Report to:
Conservation Division
State Corporation Commission
211 No. Broadway
Wichita, Kansas

WELL PLUGGING RECORD

NORTH

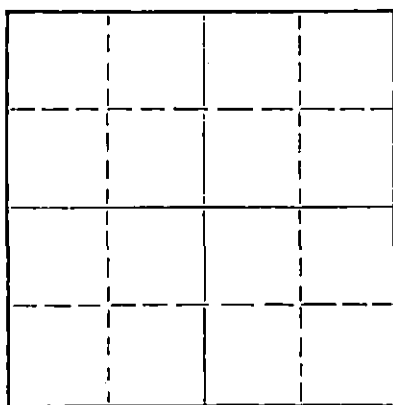

Locate well correctly on above
Section Plat

Pratt County. Sec. 24 Twp. 27 Rge. 13 (E) W (W)
Location as "NE/CNW/SW" or footage from lines SE SE SE
Lease Owner Aylward Drilling Company
Lease Name Helemke Well No. B 1
Office Address Wichita, Kansas
Character of Well (completed as Oil, Gas or Dry Hole) _____
Date well completed _____ 19____
Application for plugging filed _____ 19____
Application for plugging approved _____ 19____
Plugging commenced 5-15-61 _____ 19____
Plugging completed 5-18-61 _____ 19____
Reason for abandonment of well or producing formation Depleted.

If a producing well is abandoned, date of last production _____ 19____
Was permission obtained from the Conservation Division or its agents before plugging was commenced? yes

Name of Conservation Agent who supervised plugging of this well Fred Hampel
Producing formation _____ Depth to top _____ Bottom _____ Total Depth of Well 4351 Feet
Show depth and thickness of all water, oil and gas formations.

OIL, GAS OR WATER RECORDS

CASING RECORD

FORMATION	CONTENT	FROM	TO	SIZE	PUT IN	PULLED OUT
				8-5/8"	206	None
				5-1/2"	4351'	3851'

Describe in detail the manner in which the well was plugged, indicating where the mud fluid was placed and the method or methods used in introducing it into the hole. If cement or other plugs were used, state the character of same and depth placed, from _____ feet to _____ feet for each plug set.

Checked hole to 4275', sanded to 4100' and dumped 5 sacks of cement @ 4100' with dump bailer. Pulled 5 1/2" casing. Bailed hole to 200', set 10' rock bridge to 190' and ran 20 sacks of cement. Mudded to 40' set 10' rock bridge to 30' and ran 10 sacks of cement to base of cellar.

PLUGGING COMPLETE.

RECEIVED
STATE CORPORATION COMMISSION
JUN 27 1962
CONSERVATION DIVISION
Wichita, Kansas

(If additional description is necessary, use BACK of this sheet)

Name of Plugging Contractor Knight Casing Pulling Co.
Address Chase, Kansas

STATE OF Kansas COUNTY OF Rice, ss.
Noel J. Knight (employee of owner) or (XXXXXX) of the above-described well, being first duly sworn on oath, says: That I have knowledge of the facts, statements, and matters herein contained and the log of the above-described well as filed and that the same are true and correct. So help me God.

(Signature) Noel J. Knight
Chase, Kansas

(Address)

SUBSCRIBED AND SWORN TO before me this 19th day of May, 19 61

My commission expires May 20, 1964

Notary Public.



HELMKE "B" NO. 1

Casing Record: Company: Aylward Drilling Company Location: SE SE SE 24-27-13W
Contractor: Aylward Drilling Company Pratt County
Kansas
8 5/8" - 211'
5 1/2" - 4351'
Commenced: April 2, 1961
Completed: April 14, 1961 Elev. 1888 D.F. - 1891 R.B.

	From	To	Remarks
Sand & Shale	0	145	Set 8 5/8" @ 211' w/175 sacks cement
Shale & Shells	145	211	
Red Bed	211	320	Geological Tops:
Shale	320	1215	
Lime & Shale	1215	1775	Heebner 3556
Shale & Lime	1775	1955	Toronto 3571
Lime & Shale	1955	2575	Douglas 3599
Shale & Lime	2575	2755	Brown Lime 3732
Lime & Shale	2755	2900	Lansing 3751
Shale & Lime	2900	3070	Base Kansas City 4096
Lime & Shale	3070	3220	Marmaton 4108
Shale & Lime	3220	3340	Mississippi 4190
Lime & Shale	3340	3410	Viola 4230
Lime	3410	4229	Simpson Shale 4300
Lime & Chert	4229	4318	Simpson Dolomite 4310
Lime	4318	4322	Simpson Sandstone 4334
Sand	4322	4351 T.D.	

DST 4295-4322 Open 1 1/2 hr. Str. blow
Gas to surf. in 40 min., TSTM
Rec. 135' sl. G&OCM
IBHP 510#/20" - FBHP 540#/30"
FP 45#-60#

Set 5 1/2" casing @ 4351' w/75 sacks cement
and 20 gal. latex.

Perf. 4342-50 - 4 shots per ft.
Hole full of water, squeezed
Perf. 4314-24 - 4 shots per ft.
No show - 500 mud acid
Made 3 B/O overnight
1500 acid - Swab 8 B/F - 25% oil overnight
Frac. 3000 sand, 3000 acid water
Swab 7 1/2 B/F - 1 1/2 B/O overnight
Perf. 4118-26 w/25 holes
" 4144-52 w/25 holes
No show. 500 mud acid - no show.

D & A

I hereby certify that this is a true and correct copy of the above log to the best of my knowledge.

Charles O. Williams

Subscribed and sworn to before me this 12th day of May, 1961

Duane Jessup
DUANE JESSUP Notary Public

My commission expires December 11, 1961

RELEASED
STATE CORPORATION COM. DIVISION
JUN 27 1962
CONSERVATION DIVISION
Wichita, Kansas