


WELL PLUGGING RECORD

Give All Information Completely  
Make Required Affidavit  
Mail or Deliver Report to:  
Conservation Division  
State Corporation Commission  
211 No. Broadway  
Wichita, Kansas

Pratt County, Sec. 1 Twp. 27 Rge. 14 (E) (W)  
Location as "NE/CNW/SW" or footage from lines NW SW SW  
Lease Owner Dunne-Gardner Drilling Co., Inc.  
Lease Name Hoener Well No. 1  
Office Address 300 Schweiter Building, Wichita, Kansas  
Character of Well (completed as Oil, Gas or Dry Hole) Dry Hole  
Date well completed November 16 19 63  
Application for plugging filed 19  
Application for plugging approved 19  
Plugging commenced November 16 19 63  
Plugging completed November 16 19 63  
Reason for abandonment of well or producing formation D & A

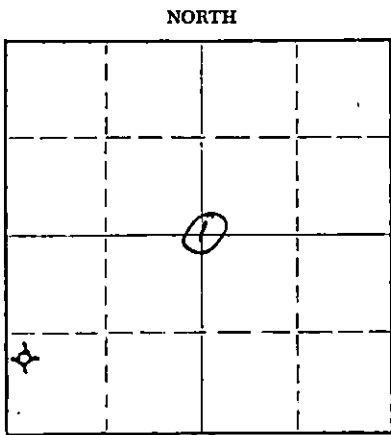

Locate well correctly on above  
Section Plat

If a producing well is abandoned, date of last production 19  
Was permission obtained from the Conservation Division or its agents before plugging was com-  
menced? yes

Name of Conservation Agent who supervised plugging of this well Archie Elving  
Producing formation Depth to top Bottom Total Depth of Well 4600 Feet  
Show depth and thickness of all water, oil and gas formations.

OIL, GAS OR WATER RECORDS

CASING RECORD

FORMATION	CONTENT	FROM	TO	SIZE	PUT IN	PULLED OUT
Surface		0	353	8-5/8	11-6-63	None

Describe in detail the manner in which the well was plugged, indicating where the mud fluid was placed and the method or methods used in introducing it into the hole. If cement or other plugs were used, state the character of same and depth placed, from feet to feet for each plug set.

Fill hole with mud to 300 feet from surface, set plug, 1/2 sack hulls and 25 sacks cement. Fill casing with mud to 40 feet from surface, set plug, 1/2 sack hulls and 10 sacks cement. Fill rathole with 2 sacks cement.

RECEIVED  
STATE CORPORATION COMMISSION

NOV 20 1963  
11-20-63  
CONSERVATION DIVISION  
Wichita, Kansas

(If additional description is necessary, use BACK of this sheet)

Name of Plugging Contractor  
Address

STATE OF Kansas, COUNTY OF Sedgwick, ss.  
Don Gardner (employee of owner) or (owner or operator) of the above-described well, being first duly sworn on oath, says: That I have knowledge of the facts, statements, and matters herein contained and the log of the above-described well as filed and that the same are true and correct. So help me God.

(Signature) [Signature]  
300 Schweiter Building, Wichita, Kansas  
(Address)

SUBSCRIBED AND SWORN TO before me this 18th day of November, 19 63

My commission expires December 14, 1965

[Signature] Notary Public.

DRILLER'S LOG

OPERATOR: Dunne-Gardner Drilling Co., Inc.  
300 Schweiter Building, Wichita 2, Kansas

LEASE: Hoener

WELL: No. 1

LOCATION: NW SW SW Section 1-27A-14W  
Pratt County, Kansas

CONTRACTOR: Dunne-Gardner Drilling Co., Inc.

DATE COMMENCED: November 5, 1963

DATE COMPLETED: November 16, 1963

TOTAL DEPTH: 4600'

CASING: Set 358.84' of 8-5/8" surface pipe with 300 sacks cement.

<u>FROM</u>	<u>TO</u>	
0	250	Sand
250	353	Clay
353	885	Shale and Sand Streaks
885	905	Anhydrite
905	1704	Shale
1704	1851	Salt
1851	1873	Shale
1873	2555	Shale and Lime
2555	2710	Shale with Lime Streaks
2710	3865	Lime and Shale
3865	4375	Lime
4375	4406	Chert and Lime
4406	4490	Lime and Chert
4490	4530	Lime, Shale and Sand
4530	4558	Lime and Chert
4558	4600	Lime


**RECEIVED**  
STATE CORPORATION COMMISSION

DEC 10 1963

CONSERVATION DIVISION  
Wichita, Kansas

I certify the above to be true and correct to the best of my knowledge and belief.

DUNNE-GARDNER DRILLING CO., INC.

By   
Dan Gardner

Subscribed and sworn to before me this 26th day of November, 1963.

My Commission Expires:  
November 9, 1965

  
Marilyn E. Fox, Notary Public