


STATE OF KANSAS
STATE CORPORATION COMMISSION

WELL PLUGGING RECORD

Give All Information Completely
Make Required Affidavit
Mail or Deliver Report to:
Conservation Division
State Corporation Commission
211 No. Broadway
Wichita, Kansas

Pratt County. Sec. 1 Twp. 27S Rge. 14 (E/W) (W)

Location as "NE/CNW/SW" or footage from lines NE NE SW
Lease Owner D. R. Lauck Oil Company, Inc
Lease Name Hoener Well No. 1
Office Address 301 So. Broadway Wichita 2 Kansas
Character of Well (completed as Oil, Gas or Dry Hole) Dry hole
Date well completed December 18 19 58
Application for plugging filed " " 19 58
Application for plugging approved " " 19 58
Plugging commenced k " " 19 58
Plugging completed " k " 19 58
Reason for abandonment of well or producing formation dry hole

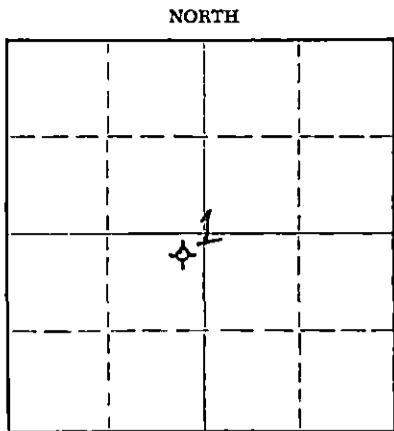

Locate well correctly on above
Section Plat

If a producing well is abandoned, date of last production _____ 19 _____
Was permission obtained from the Conservation Division or its agents before plugging was commenced? yes

Name of Conservation Agent who supervised plugging of this well Mr. Lokemp
Producing formation _____ Depth to top _____ Bottom _____ Total Depth of Well 4611 Feet
Show depth and thickness of all water, oil and gas formations.

OIL, GAS OR WATER RECORDS

CASING RECORD

FORMATION	CONTENT	FROM	TO	SIZE	PUT IN	PULLED OUT
		0	282	8 5/8"	282'	none

Describe in detail the manner in which the well was plugged, indicating where the mud fluid was placed and the method or methods used in introducing it into the hole. If cement or other plugs were used, state the character of same and depth placed, from _____ feet to _____ feet for each plug set.

hole filled with mud	4611 - 275
1/4 sack hulls & plug	275 - 271
20 sax cement & 1/4 sk hulls	271 - 35
plug	35 - 31
10 sacks cement	31 - 6 bottom of cellar

RECEIVED
STATE CORPORATION COMMISSION
DEC 30 1958
12-30-58
CONSERVATION DIVISION
Wichita, Kansas

(If additional description is necessary, use BACK of this sheet)
Name of Plugging Contractor Globe Cementing Company
Address Great Bend Kansas

STATE OF Kansas, COUNTY OF Sedgwick, ss.
John H. Knightley (employee of owner) of the above-described well, being first duly sworn on oath, says: That I have knowledge of the facts, statements, and matters herein contained and the log of the above-described well as filed and that the same are true and correct. So help me God.

(Signature) John H. Knightley
Wichita Kansas
(Address)

SUBSCRIBED AND SWORN TO before me this 29 day of December, 19 58

My commission expires Sept. 14, 1959

Elizabeth Gay
Notary Public.

PLUGGING
FILE SEC. 1 T 27 R 14
BOOK PAGE 9 LINE 4

D/ R. Lauck Oil Company, Inc.

Hoener #1

NE NE SW Sec.1-27S-14W
Pratt County Kansas

Commenced: November 30, 1958

Completed: December 18, 1958

Casing Record: 282' 8 5/8" cemented with 225 sx
Cal.Chloride 4 sx

Elevations: GR 1974; DF 1976; KB 1978

Drillers Log

Tops

		<u>Sample</u>	<u>Schlumberger</u>
Sand & Clay	75		
shale	100		
sand	190	Anhydrite	870+1108
Shale & Red Bed	282	Heebner	3667-1689 3666-1688
Red Bed	520	Douglas	3694-1716 3696-1718
Sand	550	Brown Lime	3832-1854 3830-1852
Red Bed	685	Lansing	3860-1882 3858-1880
Sand	735	Mississippian	4293-2315 4294-2316
shale	840	Kinderhook	4368-2390 4368-2390
shale & shells	870	Viola	4395-2417 4398-2420
Anhydrite	895	Simpson Shale	4472-2494 4471-2493
shale & shells	1850	Arbuckle	4561-2583 4563-2585
Lime & shale	2250	Rotary Total Dep	4611-2633 4610-2632
shale & lime	2975		
shale & shells	3155	DST #1 (M-D)	4294-4304 open 1 hr; strong blow 1 hr. gas to surface in 28 min. too small to measure; recov.
shale & lime	3390		
Lime Broken	3515		
Chalky Lime	3655		
Lime & shale	3727		
Douglas Lime	3830		
Lime	4285		
shale & lime	4293		
Mississippian	4304	DST #2 (M-D)	4304-4318 open 1 hr; weak blow 1 hr. recov. 30' mud with few specks oil; IFP 16#; FFP 25#; BHP 33# in 30 min.
Lime	4330		
Lime & chert	4368		
Kinderhook	4372		
shale, lime & chert	4410		
Lime	4420		
Viola chert	4438	DST #2 (B)	4395-4420 open 45 min; weak blow 18 min. recov. 10' watery mud; IFP 0#; FFP 0#; BHP 705# in 20 min.
cherty lime	4464		
Lime	4500		
Simpson	4525		
shale	4545		
shale & lime	4570		
Lime- Arbuckle	4611	R.T.D.	D & A

PLUGGING
FILE SEC. 1 T. 27R. 14W
BOOK PAGE 9 LINE 4