


STATE OF KANSAS
STATE CORPORATION COMMISSION

WELL PLUGGING RECORD

Give All Information Completely
Make Required Affidavit
Mail or Deliver Report to:
Conservation Division
State Corporation Commission
800 Biting Building
Wichita, Kansas

Pratt County. Sec. 11 Twp. 27 Rge. (E) 11 (W)
Location as "NE/CNW/SW" or footage from lines SE SE SW
Lease Owner Claude Wentworth Drilling Company Inc.
Lease Name H. E. Huffman Well No. 1
Office Address _____
Character of Well (completed as Oil, Gas or Dry Hole) Dry Hole
Date well completed April 28 19 58
Application for plugging filed April 28 19 58
Application for plugging approved April 28 19 58
Plugging commenced April 28 19 58
Plugging completed April 28 19 58
Reason for abandonment of well or producing formation _____
Dry Hole
If a producing well is abandoned, date of last production _____ 19 _____
Was permission obtained from the Conservation Division or its agents before plugging was commenced? yes

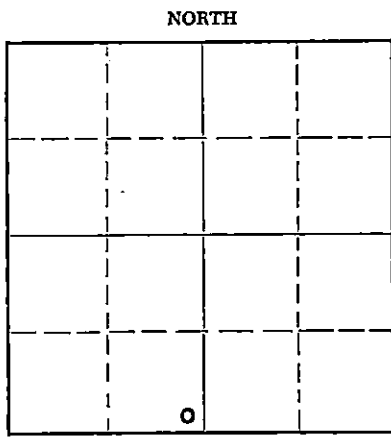

Locate well correctly on above Section Plat

Name of Conservation Agent who supervised plugging of this well Mr. W. L. Lac Kamp, Jr.
Producing formation none Depth to top _____ Bottom _____ Total Depth of Well 4667 Feet
Show depth and thickness of all water, oil and gas formations.

OIL, GAS OR WATER RECORDS

CASING RECORD

FORMATION	CONTENT	FROM	TO	SIZE	PUT IN	PULLED OUT
Surface	248'			8-5/8	248'	0

Describe in detail the manner in which the well was plugged, indicating where the mud fluid was placed and the method or methods used in introducing it into the hole. If cement or other plugs were used, state the character of same and depth placed, from _____ feet to _____ feet for each plug set.

~~Hole filled with mud from 4667' to 448', set Halliburton plug, spotted 20 sacks cement, filled with mud to 20', set Halliburton plug, filled to surface with 10 sacks cement.~~

ST. _____ COMMISSION
MAY 7 1958 05.06.58
CONSERVATION DIVISION
Wichita, Kansas

(If additional description is necessary, use BACK of this sheet)

Name of Plugging Contractor Company tools
Address _____

STATE OF Kansas, COUNTY OF Russell, ss.
Donald R. Wentworth (employee of owner) or (owner or operator) of the above-described well, being first duly sworn on oath, says: That I have knowledge of the facts, statements, and matters herein contained and the log of the above-described well as filed and that the same are true and correct. So help me God.

(Signature) Donald R. Wentworth
Russell, Kansas
(Address)

SUBSCRIBED AND SWORN TO before me this 5th day of May, 19 58
Harriet W. Peterson
Notary Public.

My commission expires March 6, 1961

PLUGGING
FILE SEC 11 T 27 R 14 W
BOOK PAGE 98 LINE 12

KANSAS GEOLOGICAL SOCIETY
 KANSAS WELL LOG BUREAU - KANSAS WELL SAMPLE BUREAU
 KANSAS GEOLOGICAL SOCIETY BUILDING
 508 EAST MURDOCK - WICHITA, KANSAS

COMPANY Claude Wentworth Drilling Co.

SEC. 11 T.27 R. 14W

FARM H. E. Huffman NO. 1

LOC. SE SE SW

TOTAL DEPTH 46678

COUNTY **Pratt**


COMM. 4-7-58

COMP. 4-28-58

KANSAS

SHOT OR TREATED

CONTRACTOR Co. Tools

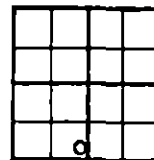

ISSUED

CASING

20	10	
15	8	248'
12	6	
13	5	

ELEVATION 1991 KB

PRODUCTION D & A

FIGURES INDICATE BOTTOM OF FORMATIONS

- 0- 120 Sand, clay
- 120- 430 Sand, red bed
- 430- 448 Shale
- 448- 605 Sand & red bed
- 605- 890 Red bed
- 890-1360 Shael & shells
- 1360-1700 Shale, shells
- 1700-1754 Shale, lime
- 1754-1940 Shale, lime
- 1940-2930 Lime, Shale
- 2930-3186 Shale, lime
- 3186-3205 Shale, sand & lime
- 3205-3367 Lime & shale
- 3367-3760 Lime
- 3760-3868 Sand & Lime
- 3868-4222 Lime
- 4222-4256 Lime & shale
- 4256-4296 Lime, shale, chert
- 4296-4371 Lime, shale
- 4371-4476 Lime, shale, chert
- 4476-4627 Lime, shale
- 4627-4667 Lime

RECEIVED
 OIL CORPORATION COMMISS

MAY 6 1958

INFORMATION DIVISION

PLUGGING
 FILE SEC 11 T.27 R.14W
 BOOK PAGE 98 LINE 12